

UNITED STATES
DEPARTMENT OF THE INTERIOR
BUREAU OF LAND MANAGEMENT


SECTION

*34

Oregon State Water Filings

TOWNSHIP 37S, RANGE 48E, W. M.

North

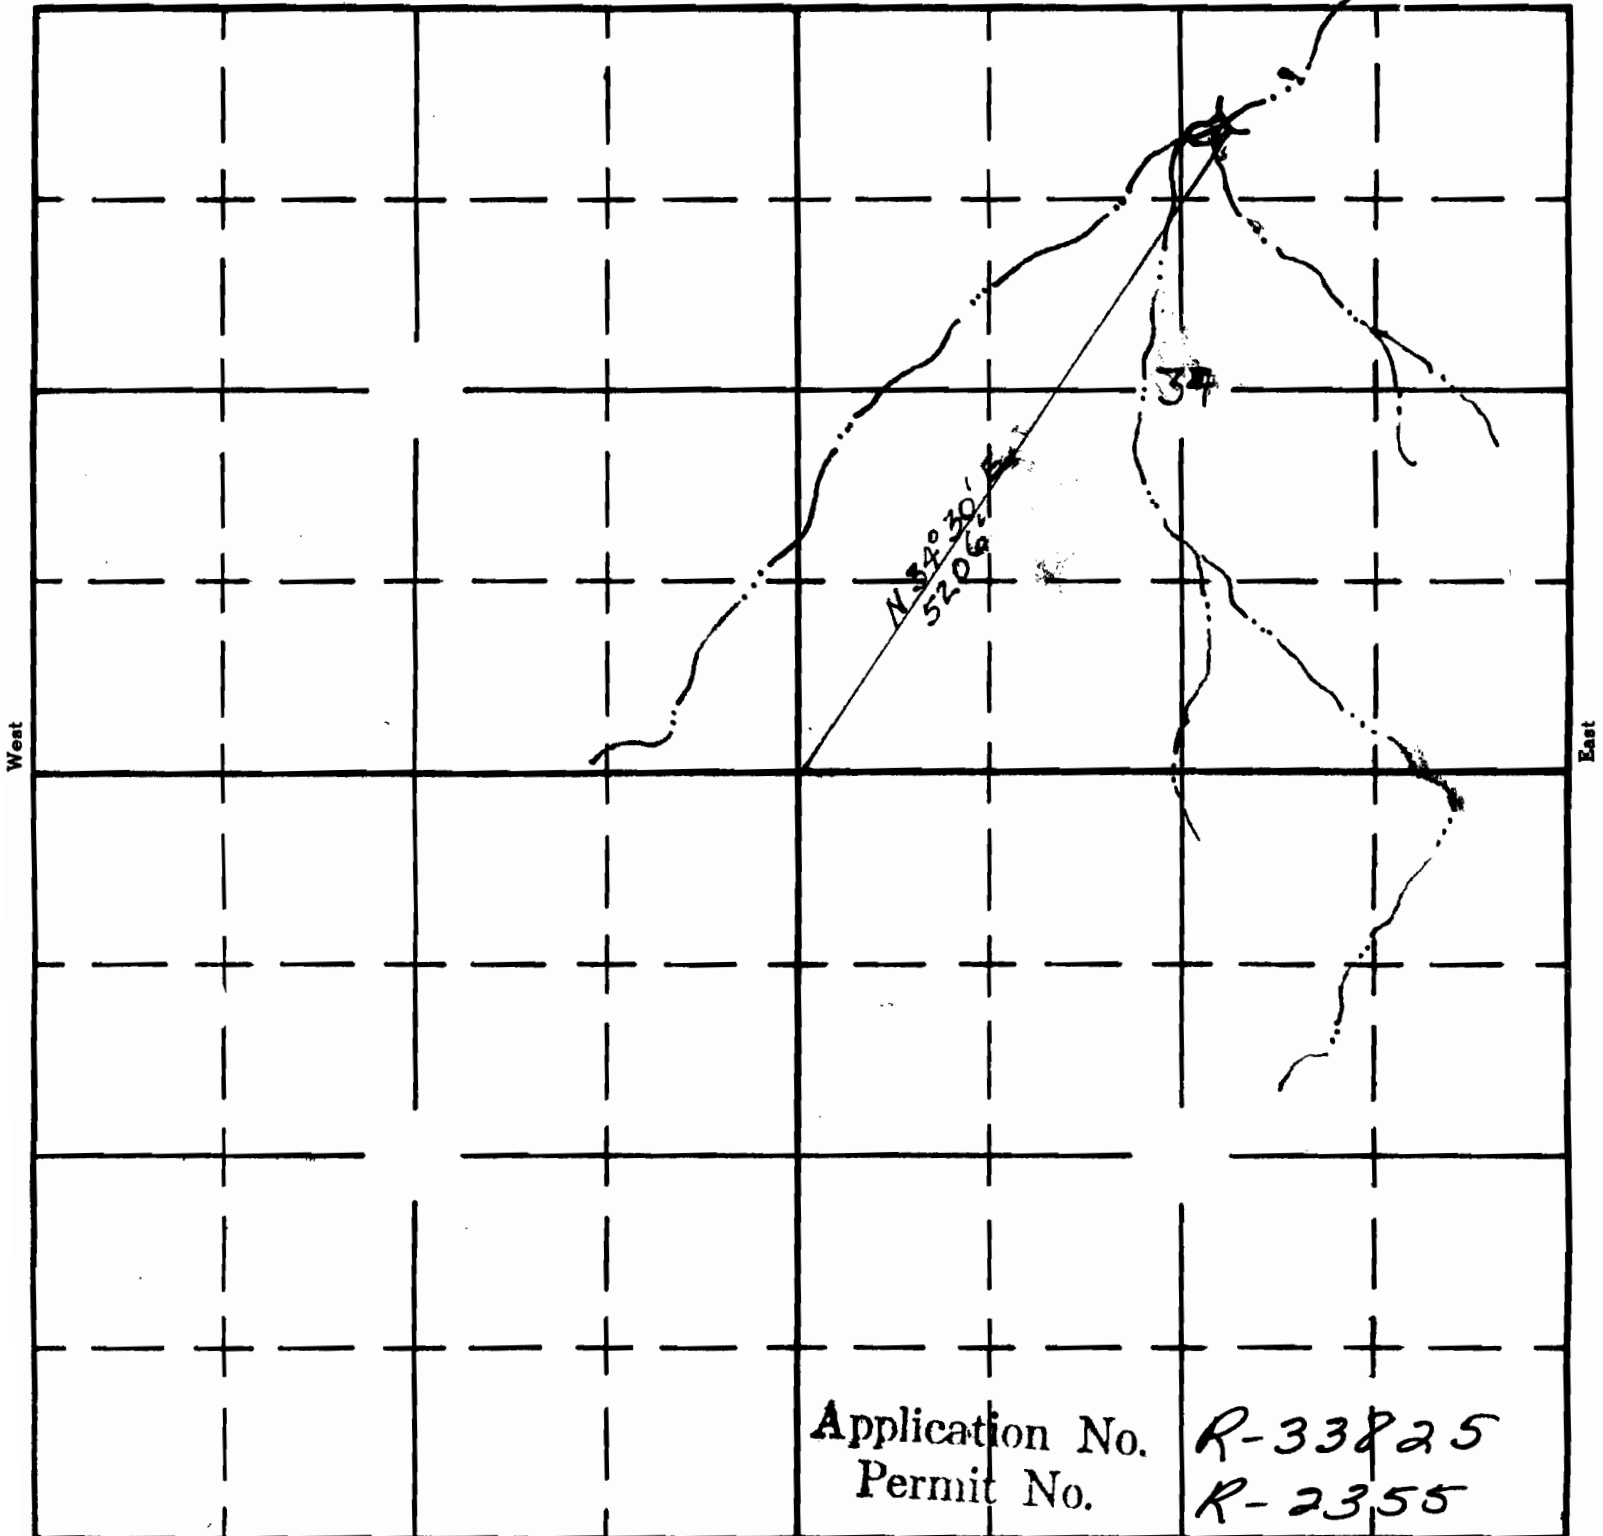

APPLICATION No.

PERMIT No.