
Form A1-187
March 1961

UNITED STATES
DEPARTMENT OF THE INTERIOR
BUREAU OF LAND MANAGEMENT

SECTION 15

Oregon State Water Filings

TOWNSHIP 40S, RANGE 3E, W. M.

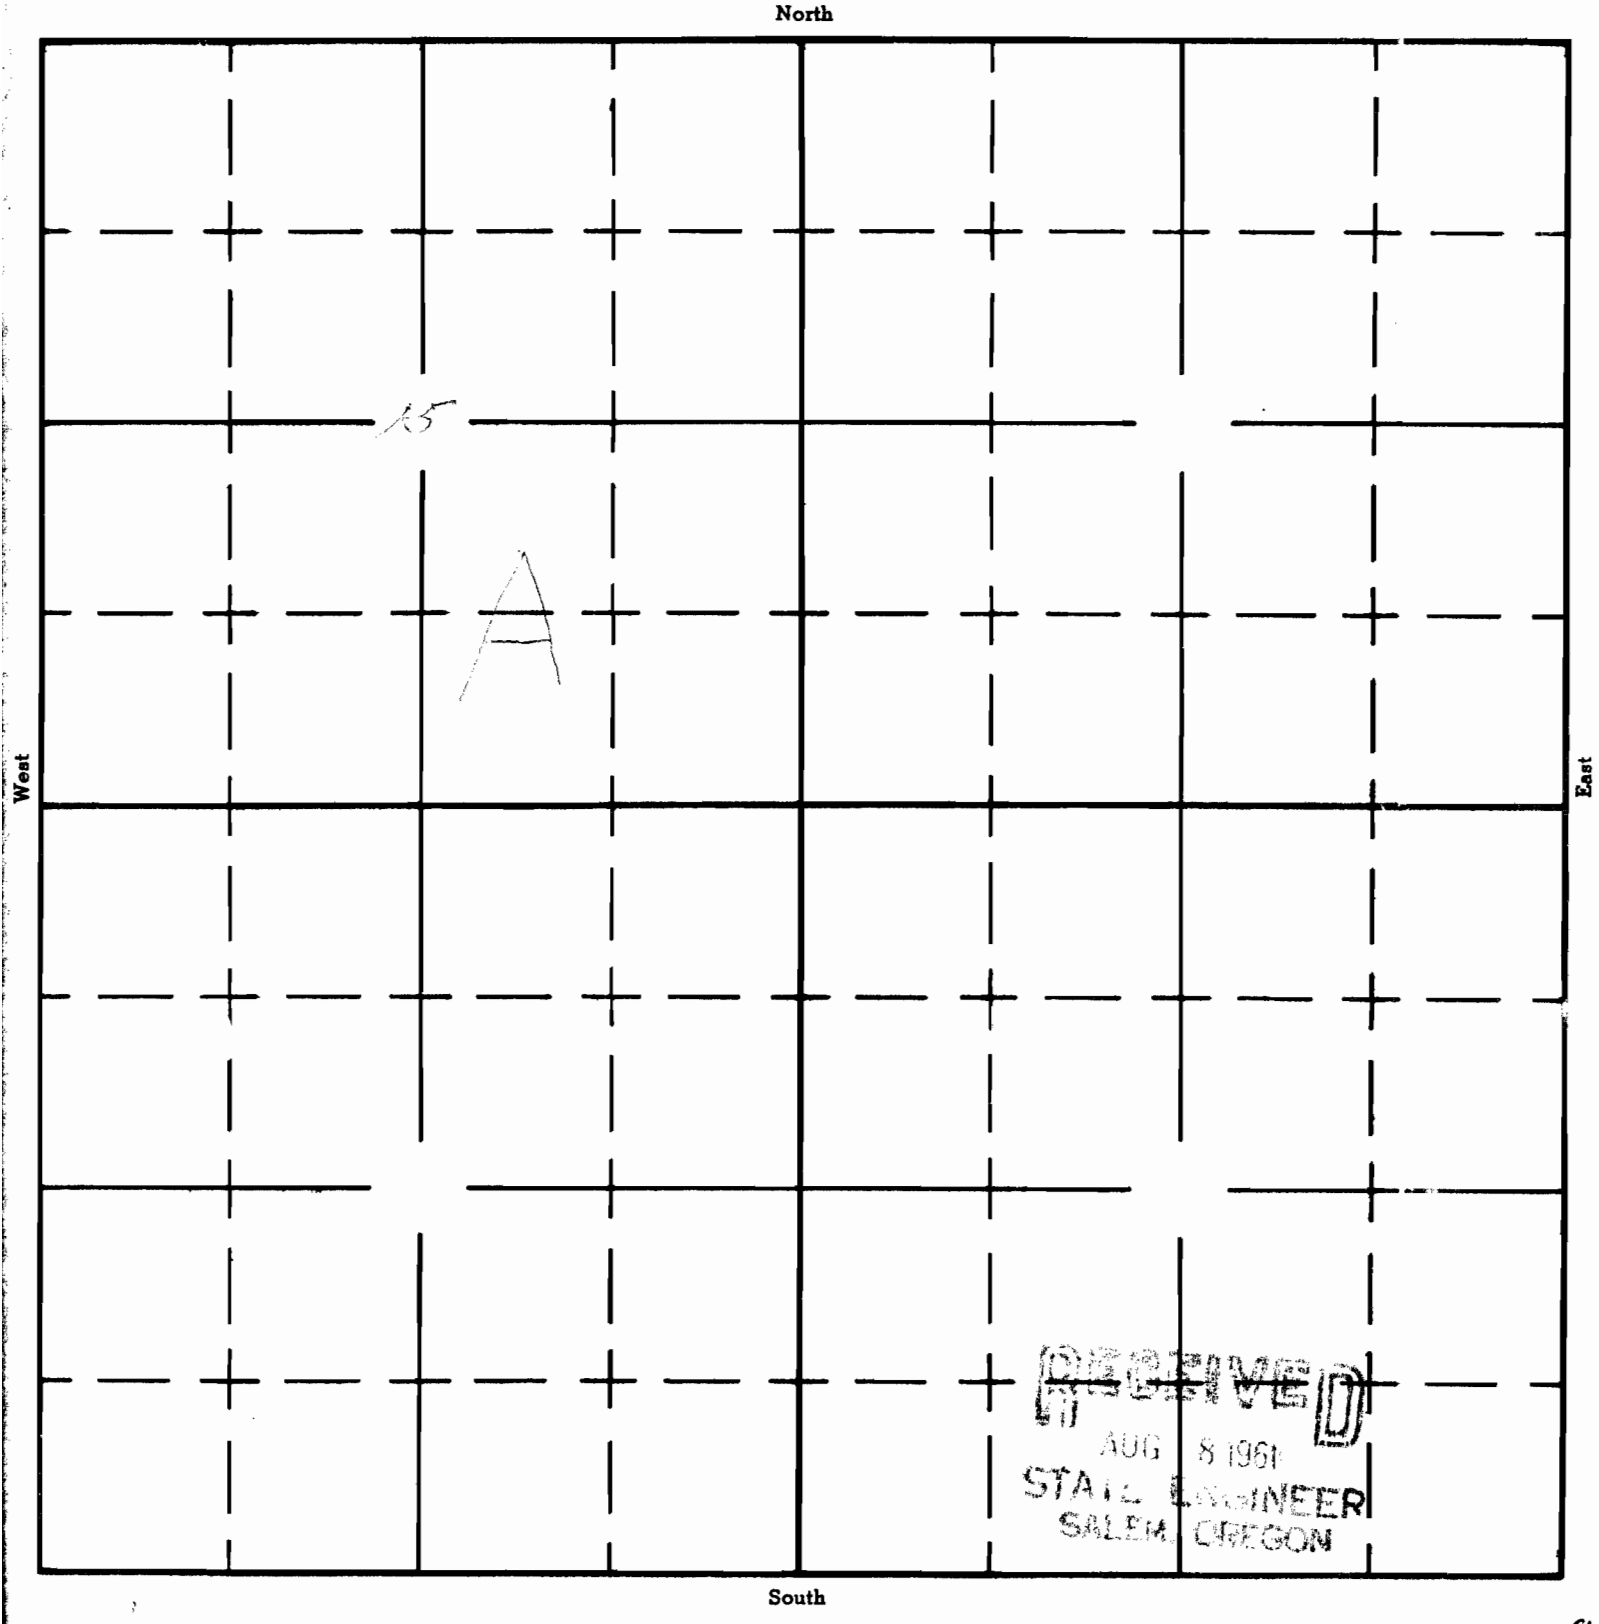

RECEIVED
AUG 8 1961
STATE ENGINEER
SALEM, OREGON

APPLICATION No. R-36768
PERMIT No. R-3934