

Form A1-187
March 1961

UNITED STATES
DEPARTMENT OF THE INTERIOR
BUREAU OF LAND MANAGEMENT

SECTION

Oregon State Water Filings


TOWNSHIP 37 S., RANGE 47 E., W. M.

26

SW 4 NE 4

North

TOPPIN CREEK #2 RESERVOIR

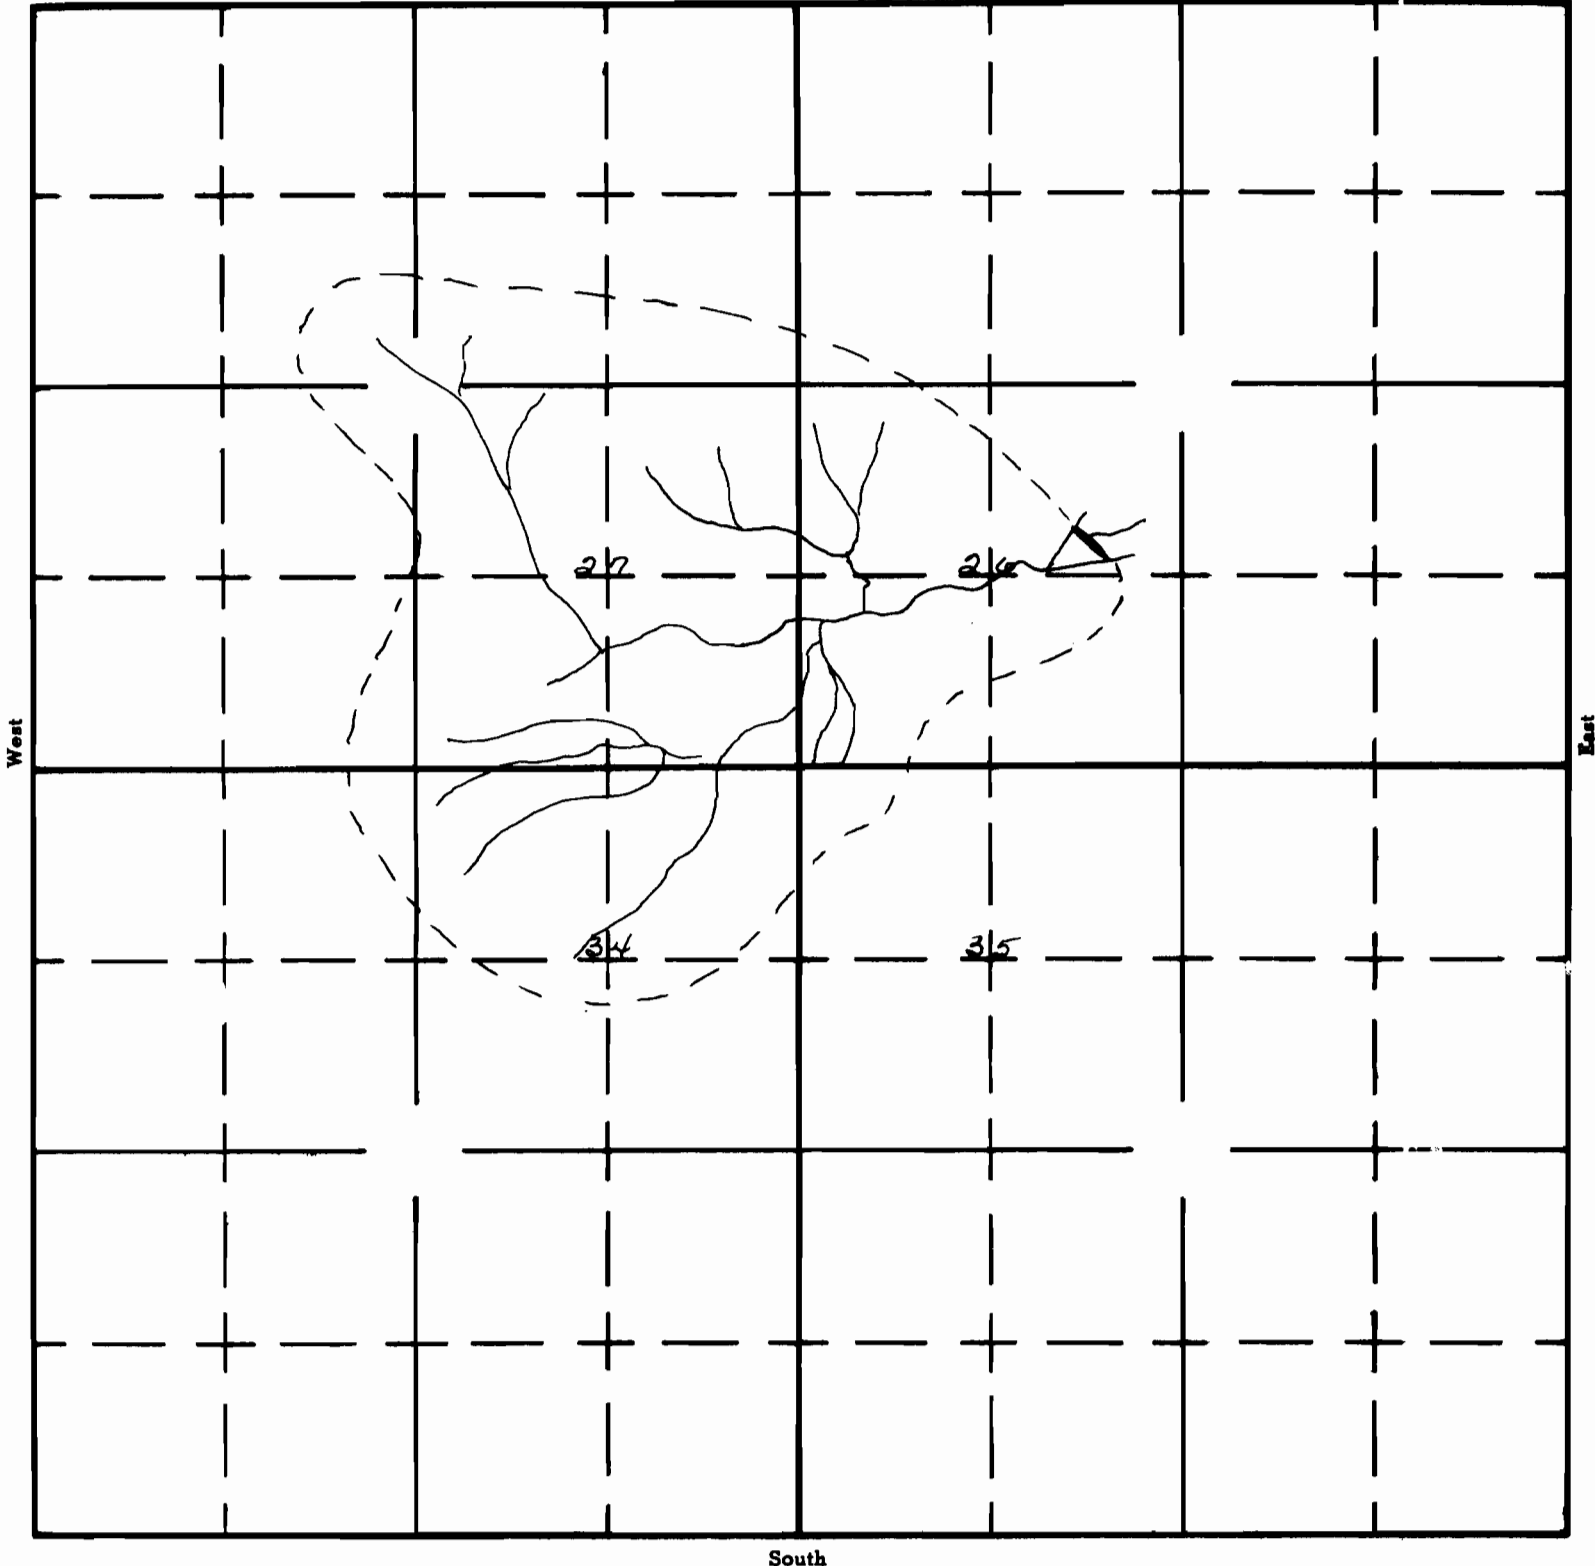

South

APPLICATION No. R-41494

PERMIT No. R-5202