



APPLICATION MAP FOR PERMIT TO CONSTRUCT A RESERVOIR

SW 1/4 SE 1/4 SEC 15 T 16S R 45E W.M.

U.S.G.S. QUAD - TUB MOUNTAIN, OREG. - 7 1/2'

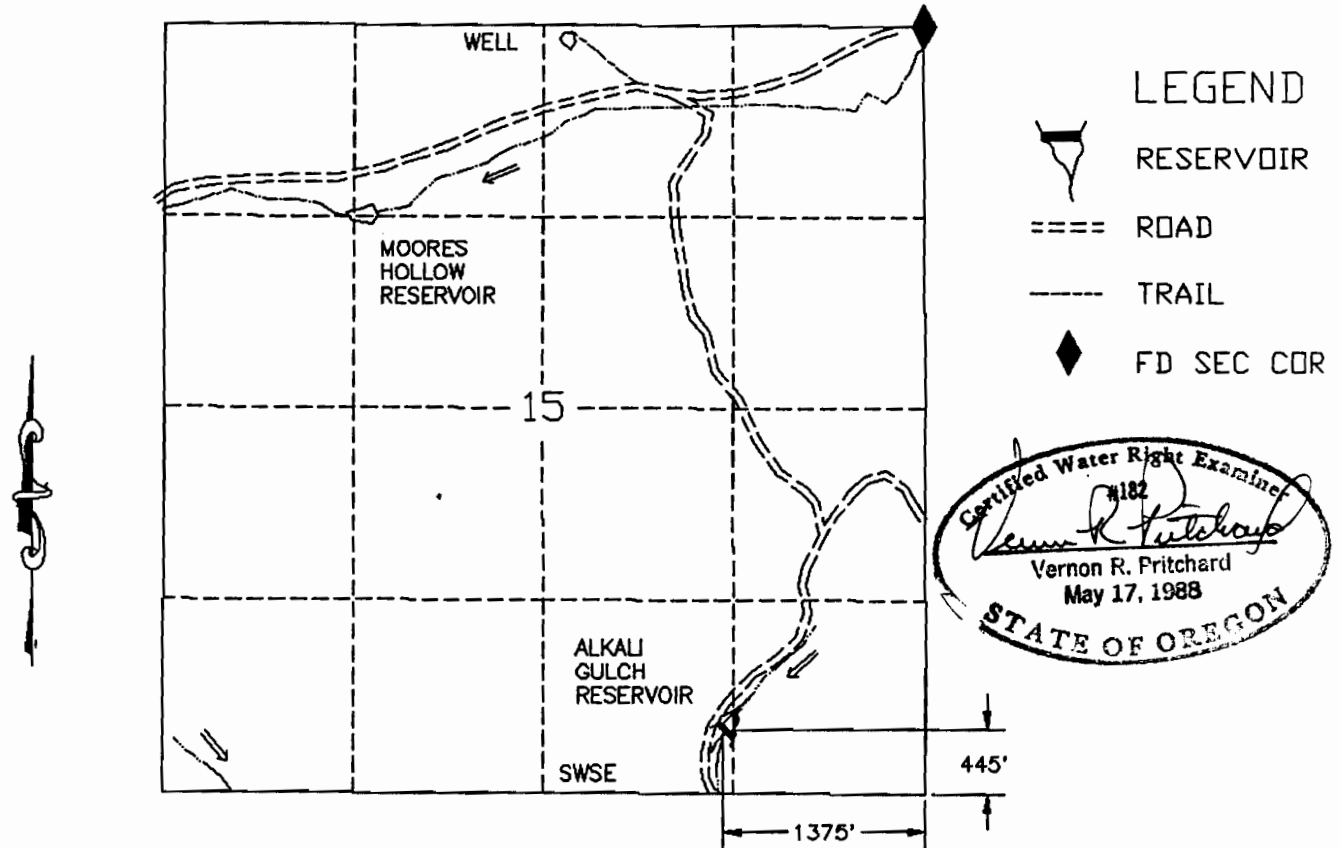

ALKALI GULCH (48-1700) RESERVOIR

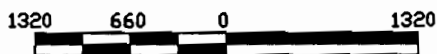

SCALE 1"=1320'

THIS MAP IS FOR THE PURPOSE OF LOCATING A WATER RIGHT AND IS NOT INTENDED TO PROVIDE LEGAL DIMENSIONS FOR LOCATION OF PROPERTY BOUNDARIES.



ACAD RELEASE 11/DCA
DVG FILE: ALKALIG.DVG

UNITED STATES DEPARTMENT OF THE INTERIOR BUREAU OF LAND MANAGEMENT DIVISION OF OPERATIONS VALE DISTRICT	
ALKALI GULCH (48-1700) RESERVOIR	
DESIGNED	<i>Vernon R. Pritchard</i>
REVIEWED	<i>Vernon R. Pritchard</i>
APPROVED	<i>Vernon R. Pritchard</i> CHIEF, BRANCH OF ENGINEERING
DRAWN: CG	SCALE: 1"=1320'
DATE: 04/23/93	SHEET 1 OF 1
DRAWING NO. DR-03-9172.45-249	