


UNITED STATES
DEPARTMENT OF THE INTERIOR
BUREAU OF LAND MANAGEMENT

SECTION
SW⁴NE⁴
SEC 16

Oregon State Water Filings
TOWNSHIP 38S, RANGE 47E, W. M.

5
10

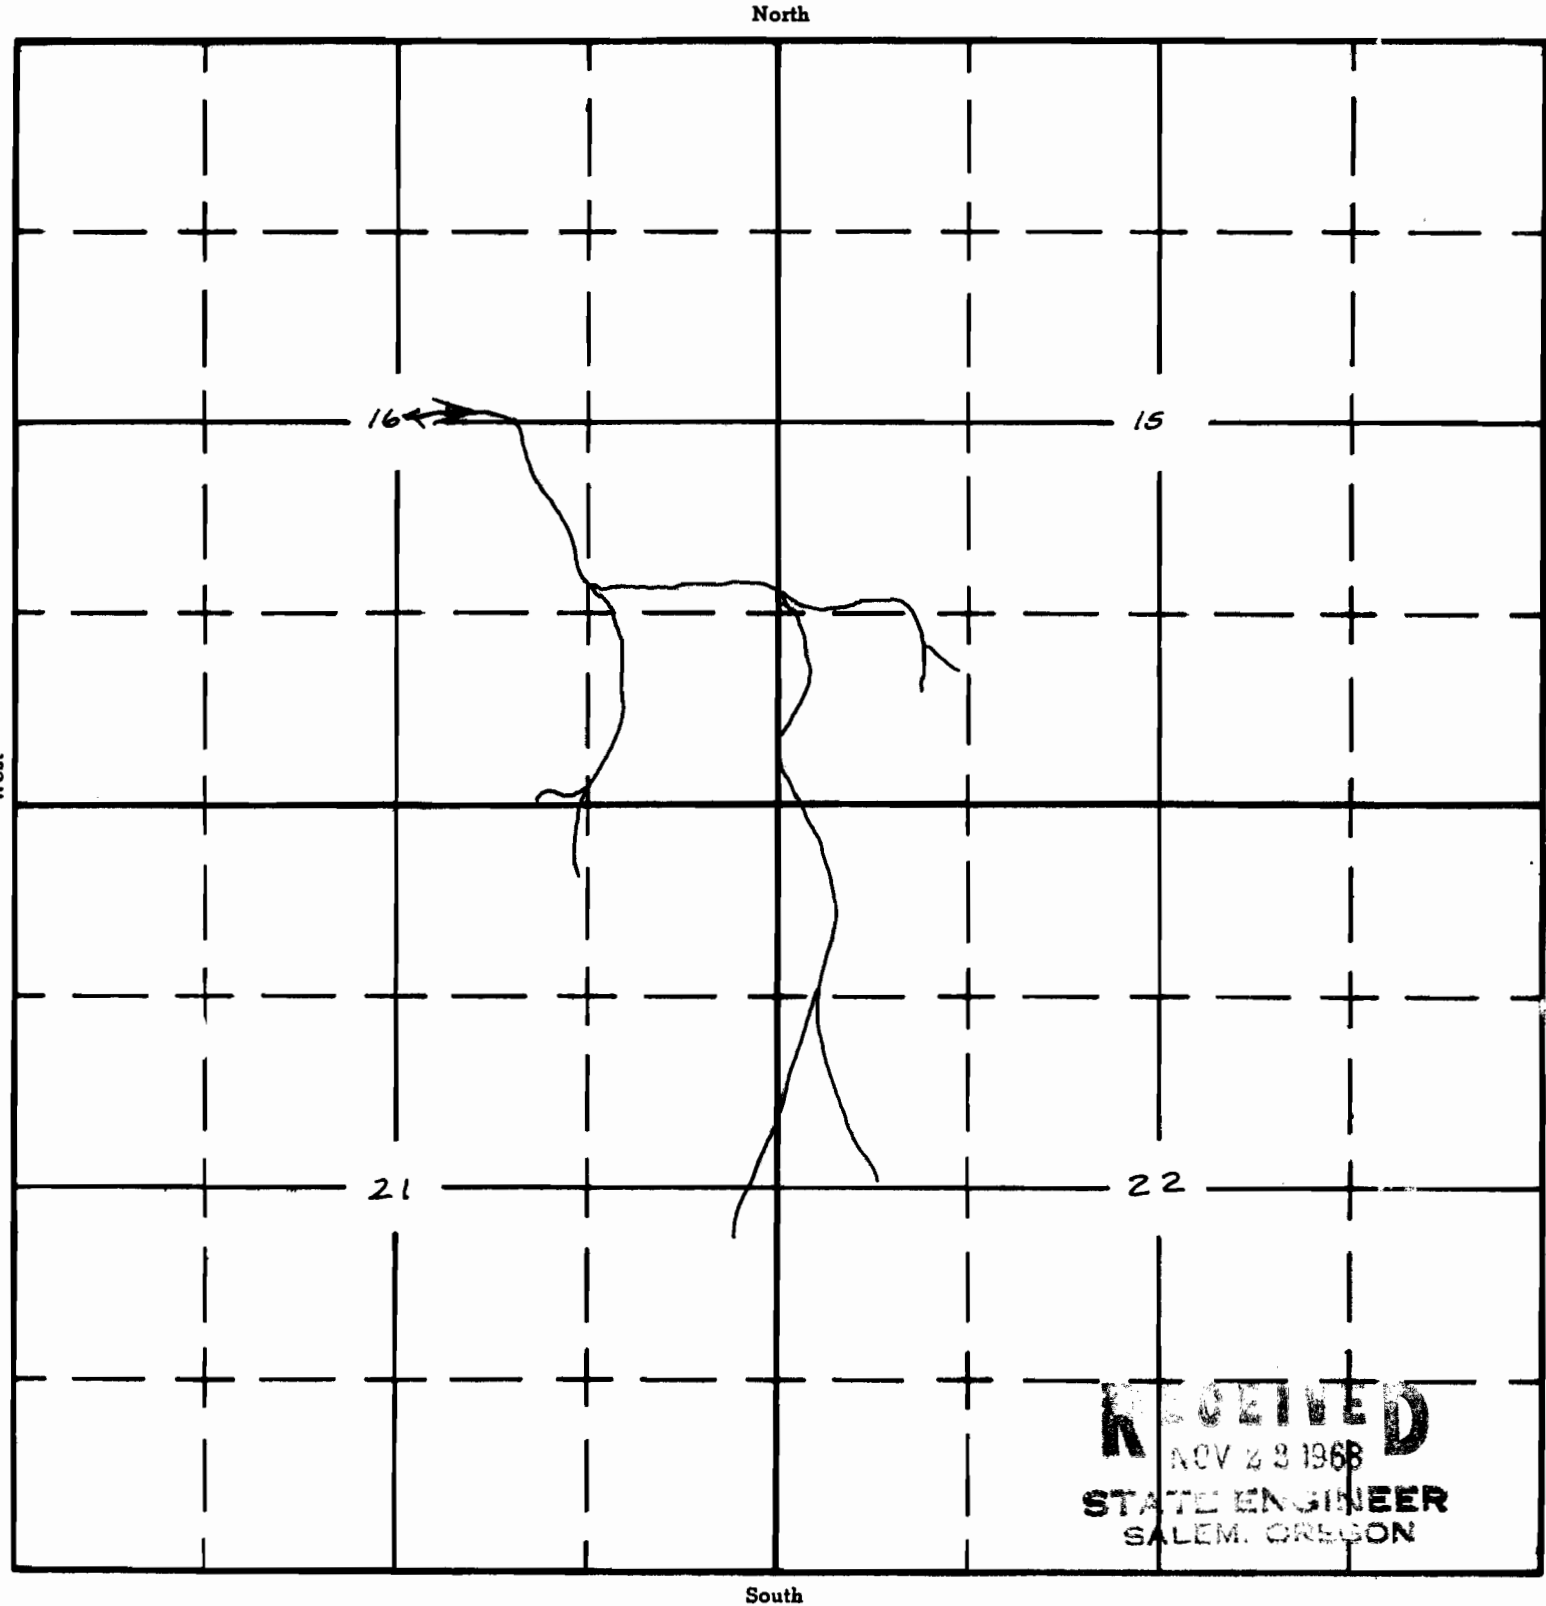

Section 16 Res.

APPLICATION No. R-45587
PERMIT No. R 7466