


T. 7S., R. 38E., W.M.

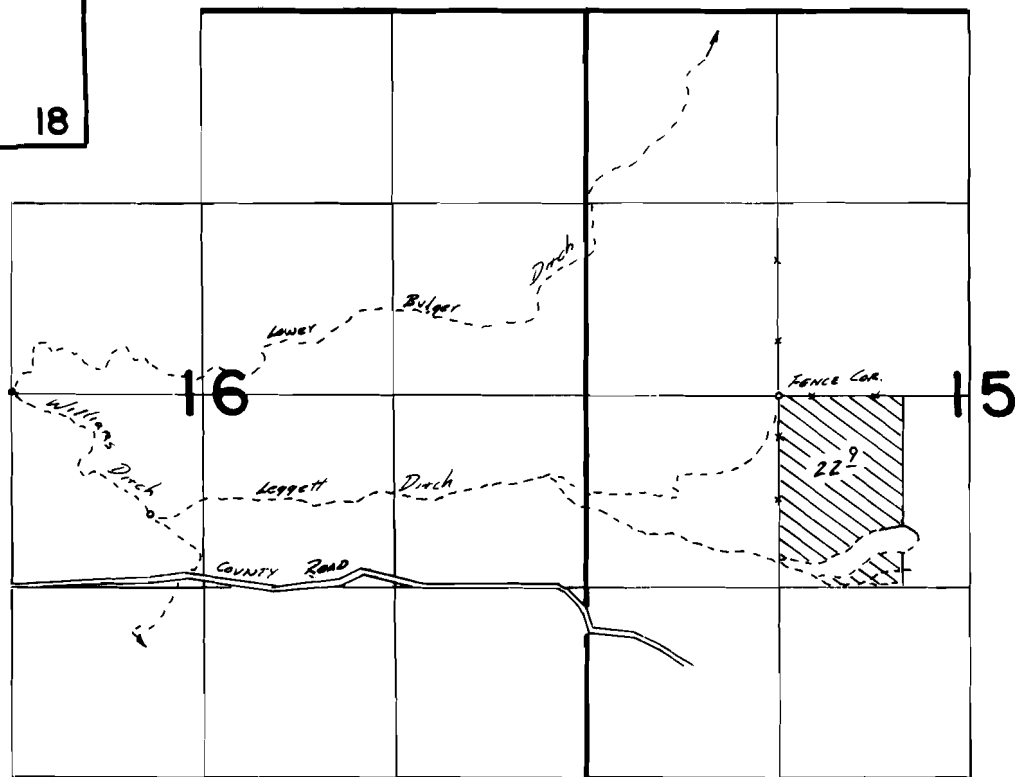

DIV. PT. LOC. 700' N. & 1620' W. FROM SE COR. SEC. 18

FINAL PROOF SURVEY UNDER

Application No. 57047 Permit No. 43102
IN NAME OF

BILLY R. & DORIS M. LEGGETT

Surveyed 4-12 1982, by V.L. Church