


T. 7S., R. 38E., W.M.

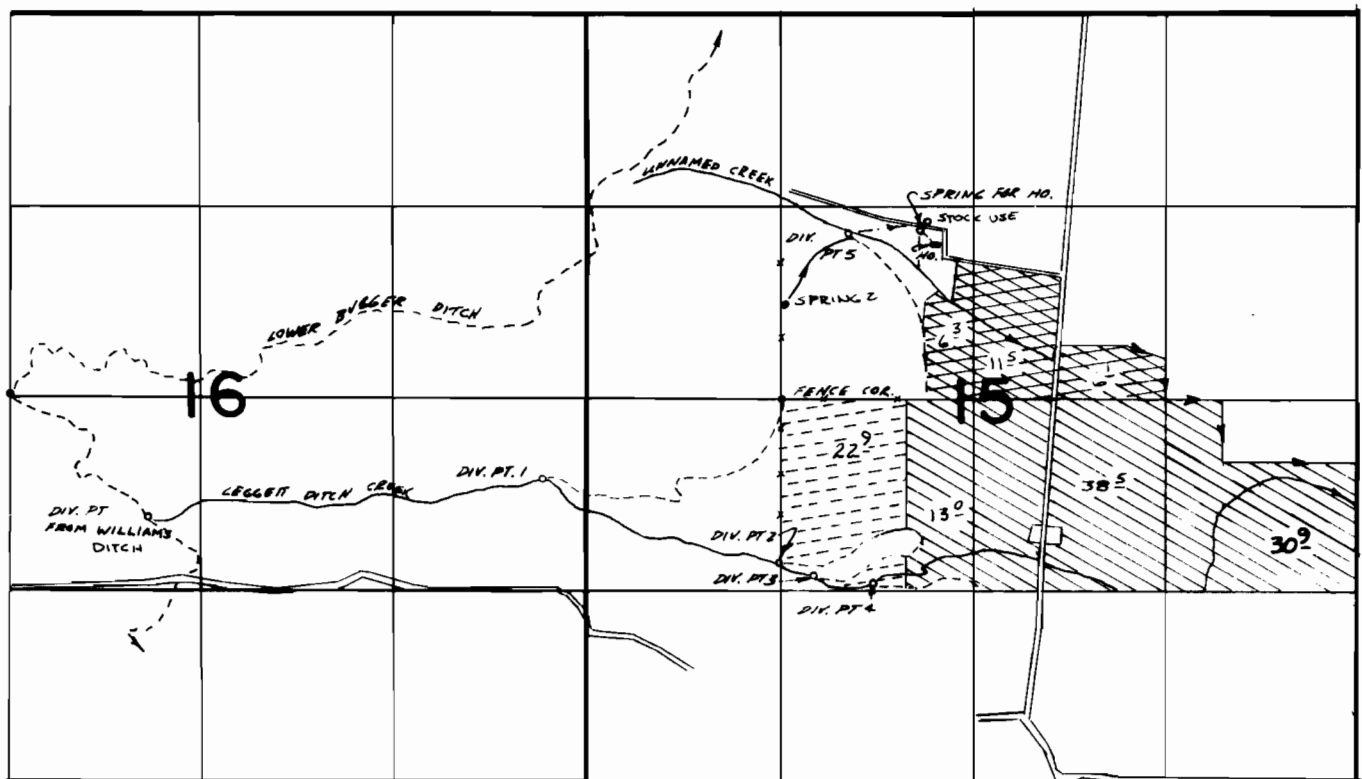

SPRING FOR HOUSE LOC: 1150' N. 360' W. FROM CENTER SEC. 15

Div. Pt. 1 Loc 550'S. & 300'W. From E 1/4 Cor. Sec 16

Div. Pt 2 Loc: 1510' N. & 1320' E FROM SW COR SEC. 15

Div. Pt. 3 Loc: 1420'N. & 1550'E FROM SW COR. SEC. 15

Div. Pt. 4 Loc: 1370' N. & 1970' E From SW COR. SEC 15

Div. Pt. S Loc: 1130' N. & 850' W. FROM CENTER SEC 15

FINAL PROOF SURVEY
UNDER

Application No. **54725**. Permit No. **43100**.....
IN NAME OF

.....BILLY R. & DORIS M. LEGGETT.

Surveyed 4-12 1982, by V. L. Church



PRIMARY FROM LEGGETT
DITCH CR.



SUPP'L FROM
UNNAMED CR



SUPPL FROM LEGGETT DITCH
CR.