


10263

7148

Secs 29
30
31
32

Tp. 2N.
R. 13 E.

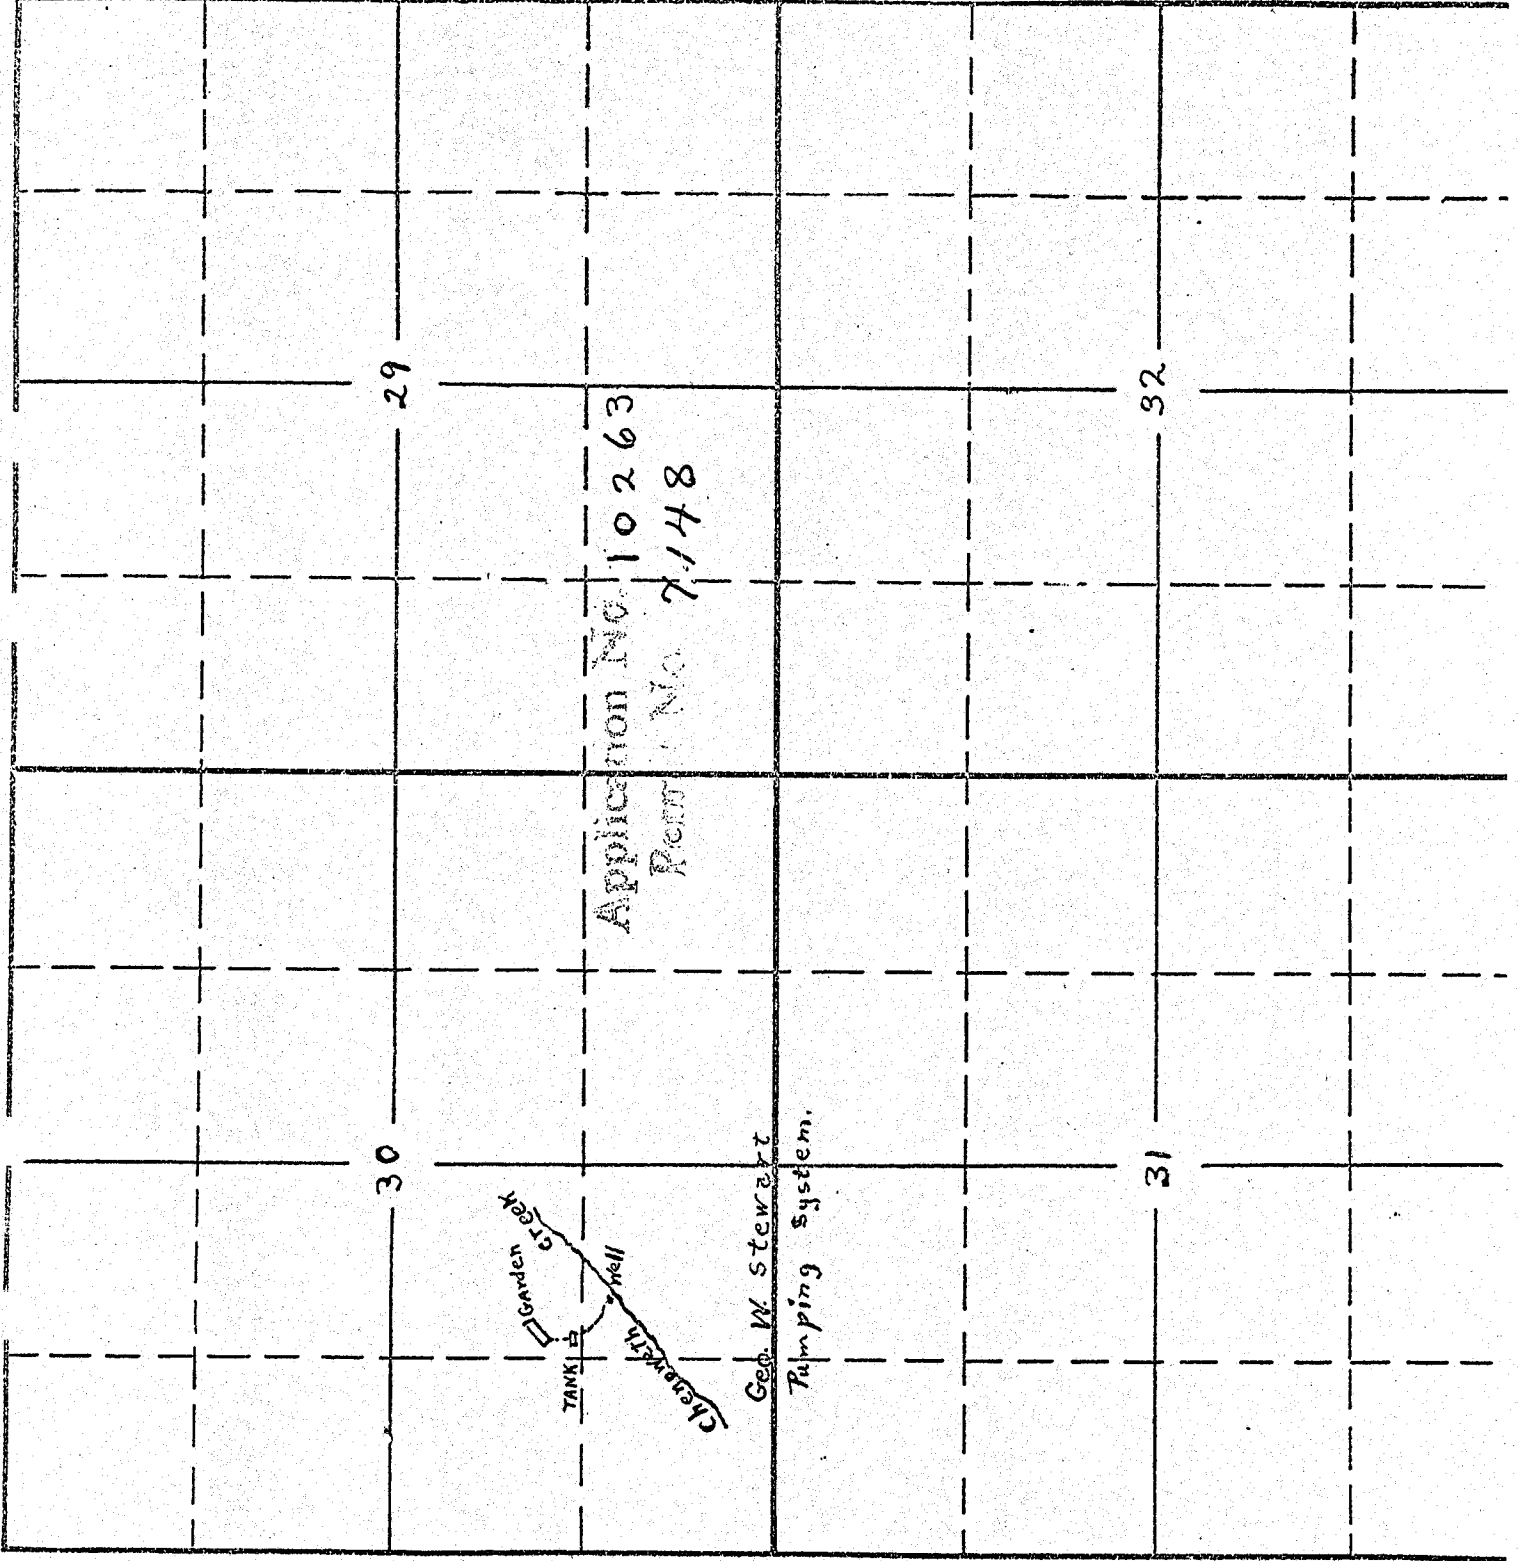

TANK
WELL

Application No. 10263
Permit No. 7148

Geo. W. Stewart
Pumping System.

29

30

32

31