


SECTION 15

NE $\frac{1}{4}$ SE $\frac{1}{4}$

TOWNSHIP 22S RANGE 42E W.M.

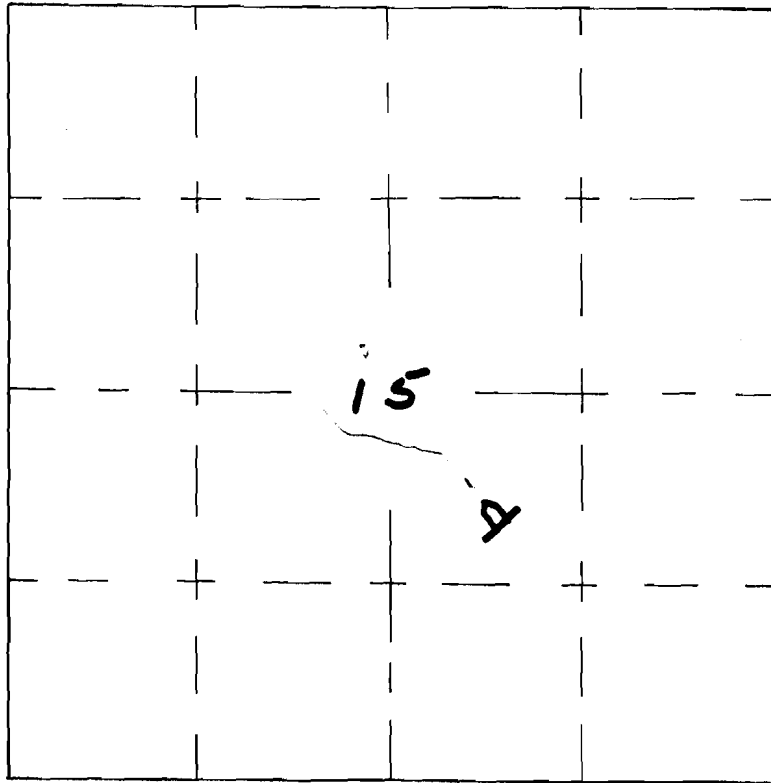


Daisey Basin
N^o R 59156

Permit No. R 8788

SECTION 15

NE $\frac{1}{4}$ SE $\frac{1}{4}$

TOWNSHIP 22S RANGE 42E W.M.

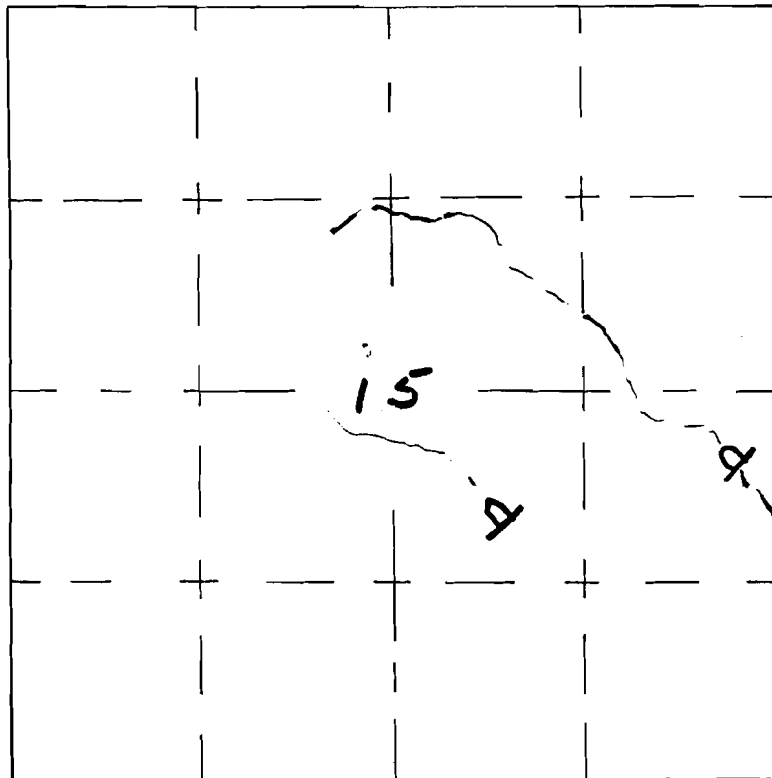

Daisey Basin
N^o R 59156

Permit No. R 8788

RECEIVED

APR 15 1996

WATER RESOURCES
SALEM, OREGON