


T. 11 S., R. 22 E., W.M.

72303
72302

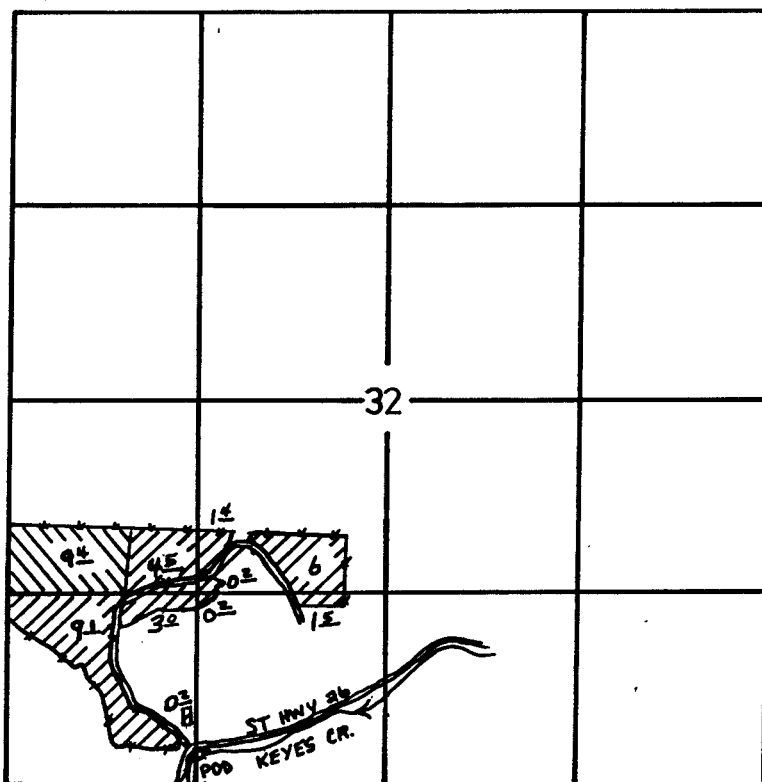

1"=1320'



P43649



P43004

POB - 190'N & 1310'W FROM S 1/4 CORNER S32

FINAL PROOF SURVEY

UNDER

Application No. 57957 Permit No. 43649
57181 43004
IN NAME OF

PATRICK G. AND LANA J. PERRY

Surveyed 4-23, 1992, by J. MILLER

41069-179-150L