

N
= 400'

FINAL PROOF MAP T.39S R.22E W.M.

VERLE EMERY

APPLICATION # R-69753

PERMIT # R-11225

EMERY RESERVOIR


SURVEYED - JULY 30, 1992

PRESENT WATER LEVEL EQUALS HIGH WATER LEVEL

ACRE FEET STORED ~ 30

SURFACE AREA ~ 3.67 ACRES


MAXIMUM DEPTH ~ 14'

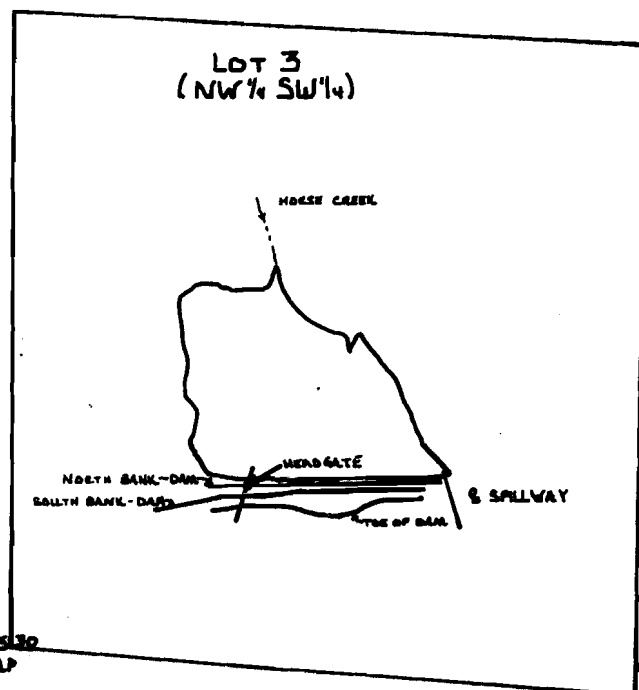

S 1/16 2530
BRASS CAP

N 56° 02' 38" E ~ 599.67' FROM
S 1/16 TO NUT ON HEADGATE

N 35° 45' E ~ 961.2' FROM
S 1/16 TO HORSE CREEK INLET

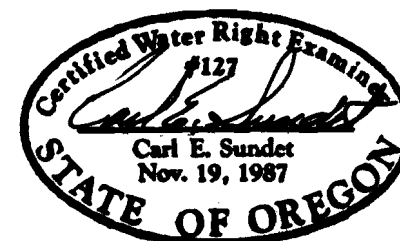

THIS MAP IS FOR THE PURPOSE OF
IDENTIFYING THE LOCATION OF THE WATER
RIGHT ONLY AND IS NOT INTENDED TO
PROVIDE LEGAL DIMENSIONS OR LOCATION
OF PROPERTY OWNERSHIP LINES

DRAWING # WR 4192
8-17-92

R-11225
78306