


T.12S.,R.43E.,W.M.  
SECTION 13

T.12S.,R.44E.,W.M.  
SECTION 18

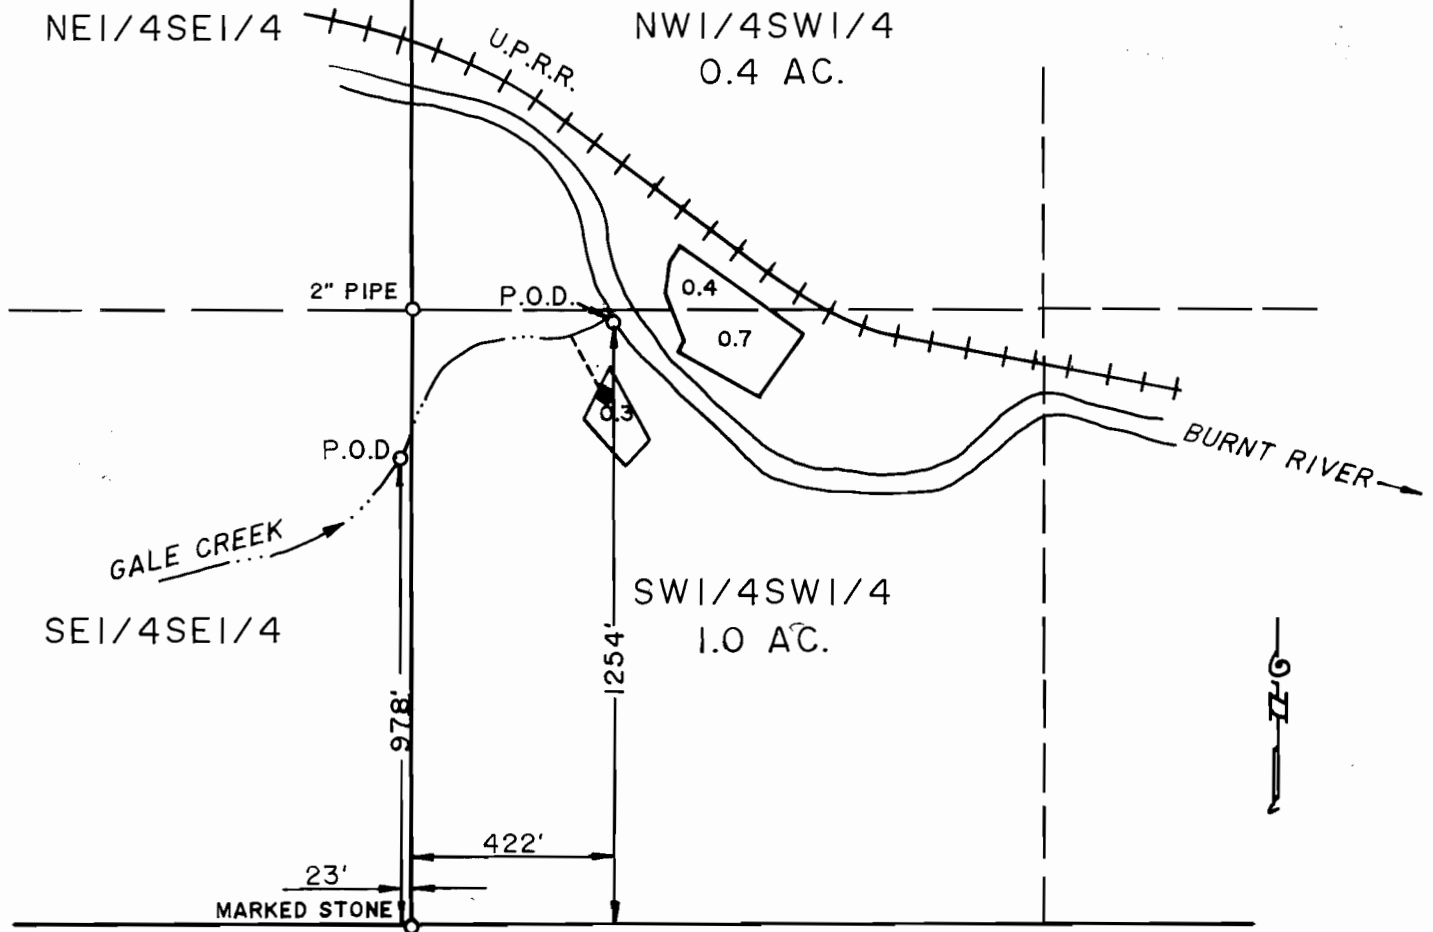

SCALE 1" = 400'

THE PURPOSE OF THIS MAP IS FOR IDENTIFYING THE LOCATION OF THE WATER RIGHT ONLY AND IS NOT INTENDED TO PROVIDE LEGAL DIMENSIONS OF PROPERTY OWNERSHIP LINES.

# FINAL PROOF SURVEY

UNDER

Application No. 70294 Permit No. 51242

IN NAME OF

MILDRED GALE

Surveyed APRIL 13, 1992

