


T.23S. R.7W W.M.

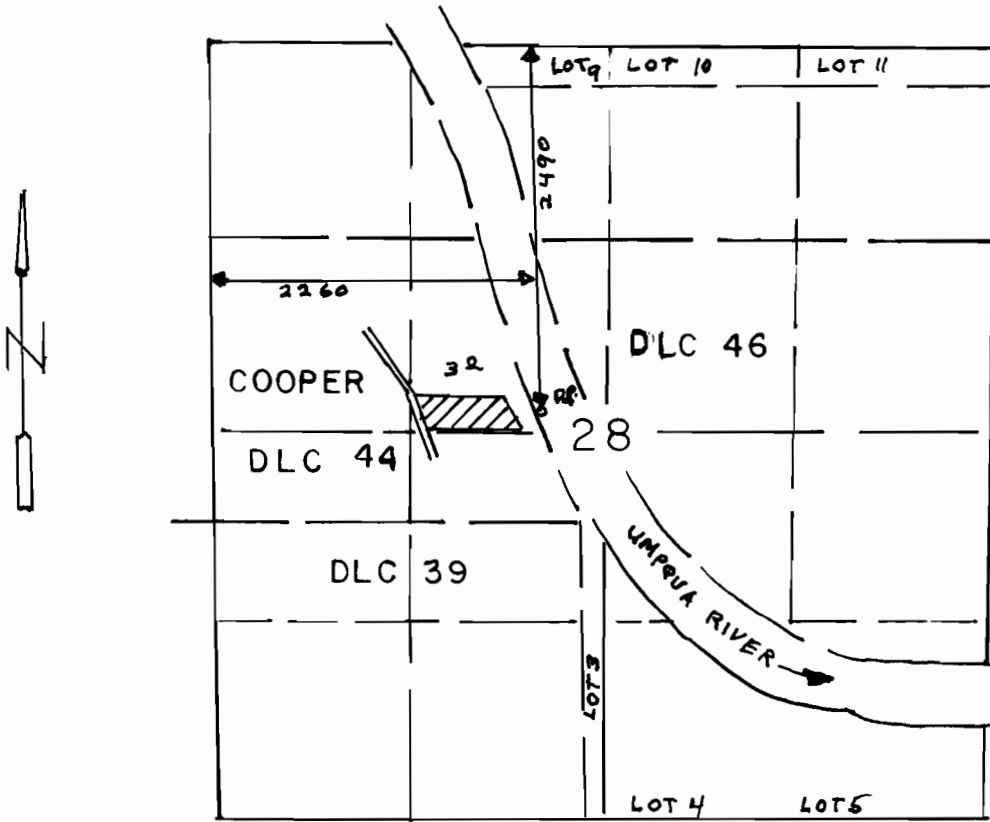

SCALE: 4" = 1 mile

THE PURPOSE OF THIS MAP IS TO IDENTIFY THE LOCATION OF THE WATER RIGHT. IT IS NOT INTENDED TO PROVIDE INFORMATION RELATIVE TO THE LOCATION OF PROPERTY OWNERSHIP BOUNDARY LINES

FINAL PROOF SURVEY
UNDER

Application No. 70295 Permit No. 51144
IN NAME OF

LEO D. GREINER
FLORENCE H. GREINER

Surveyed Aug. 16 1992, by DUANE KIRBY

