

RECEIVED

FINAL PROOF SURVEY MAP

MAY 11 1992

IN THE NAME OF PAUL Q. NELSON WATER RESOURCES DEP
SALEM, OREGON



SECTION 10, TOWNSHIP 31 SOUTH, RANGE 15 WEST, W.M.



1 INCH = 1320 FEET

APPLICATION 71379

PERMIT 51306

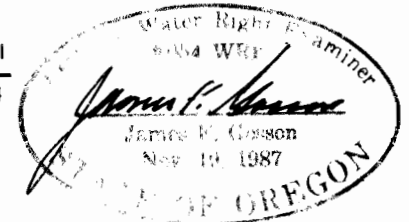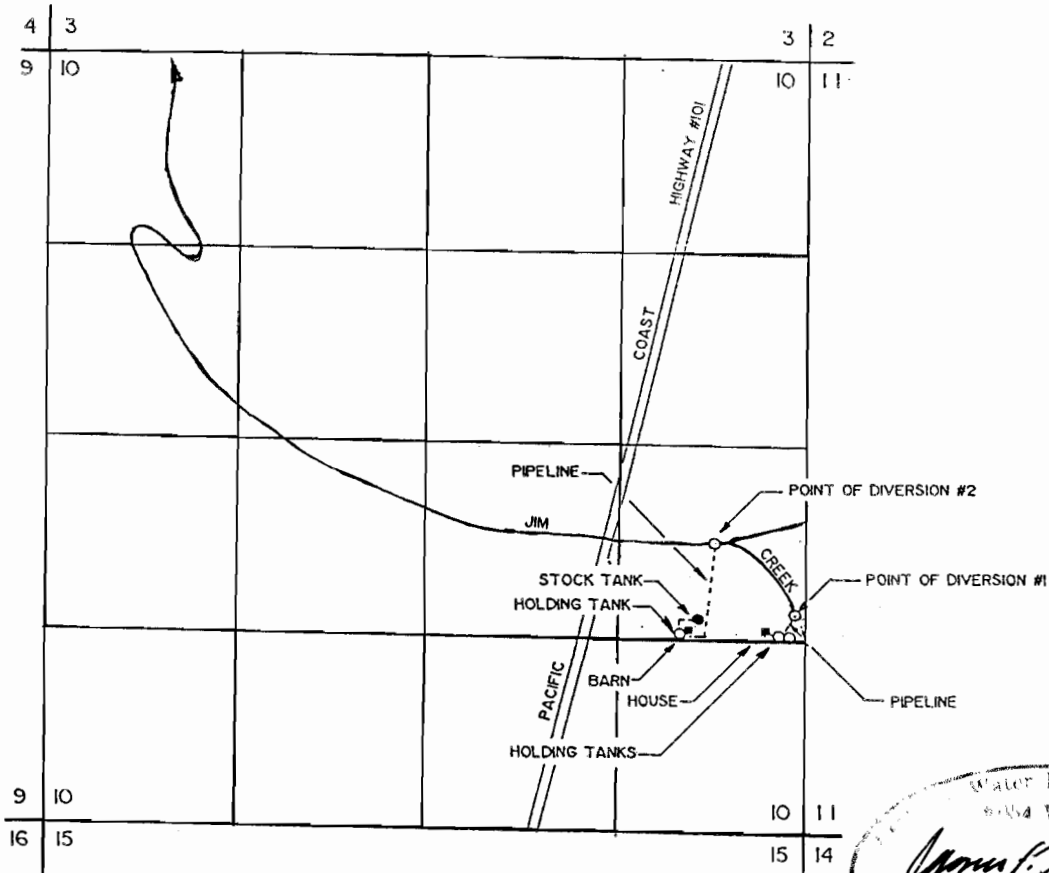

POINT OF DIVERSION #1 IS LOCATED 1180 FEET SOUTH AND 80 FEET WEST FROM THE EAST 1/4 CORNER OF SECTION 10. POINT OF DIVERSION #2 IS LOCATED 630 FEET SOUTH AND 660 FEET WEST, BOTH POINTS OF DIVERSION BEING WITHIN THE NORTHEAST 1/4 OF THE SOUTHEAST 1/4 OF SECTION 10, TOWNSHIP 31 SOUTH, RANGE 15 WEST, W.M., COOS COUNTY.

THE PURPOSE OF THIS MAP IS TO IDENTIFY THE LOCATION OF THE WATER RIGHT. IT IS NOT INTENDED TO PROVIDE INFORMATION RELATIVE TO THE LOCATION OF PROPERTY OWNERSHIP BOUNDARY LINES.