


T. 25. R. 1 W. W. M.

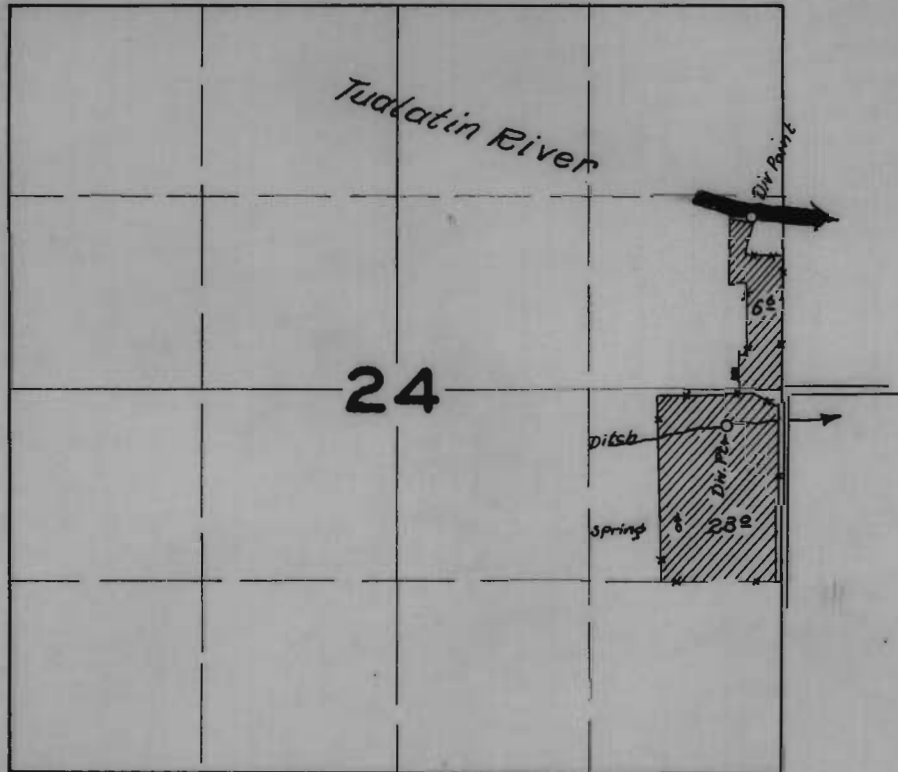

**FINAL PROOF SURVEY**

UNDER

Application No. 22881 Permit No. 17994

IN NAME OF

REIDE W. LOCKMAN and R. A. HOLMES

Surveyed 4 / 25 1952, by H. L. COFFMAN