


T. 2N. R. 3W. W.M.

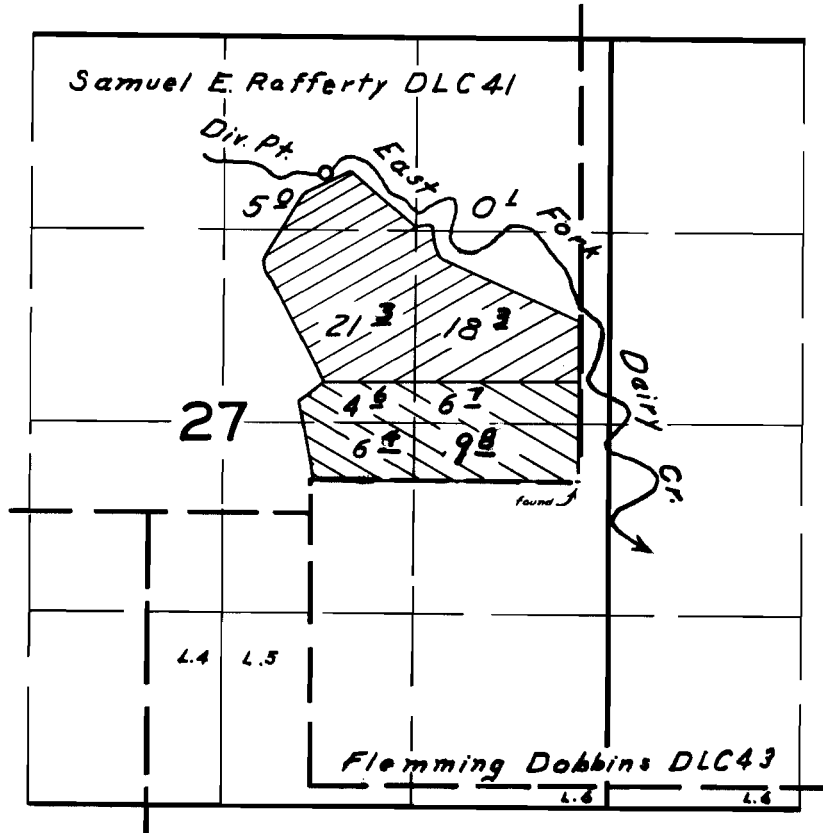

FINAL PROOF SURVEY
UNDER

Application No. 30518 Permit No. 24029
29655 23354
IN NAME OF

Rolling Hills Farms by Hollis Hardwick

Surveyed *May 9 1958* by *R.H. Whitby*