


T.1 S.R.3 W. W.M.

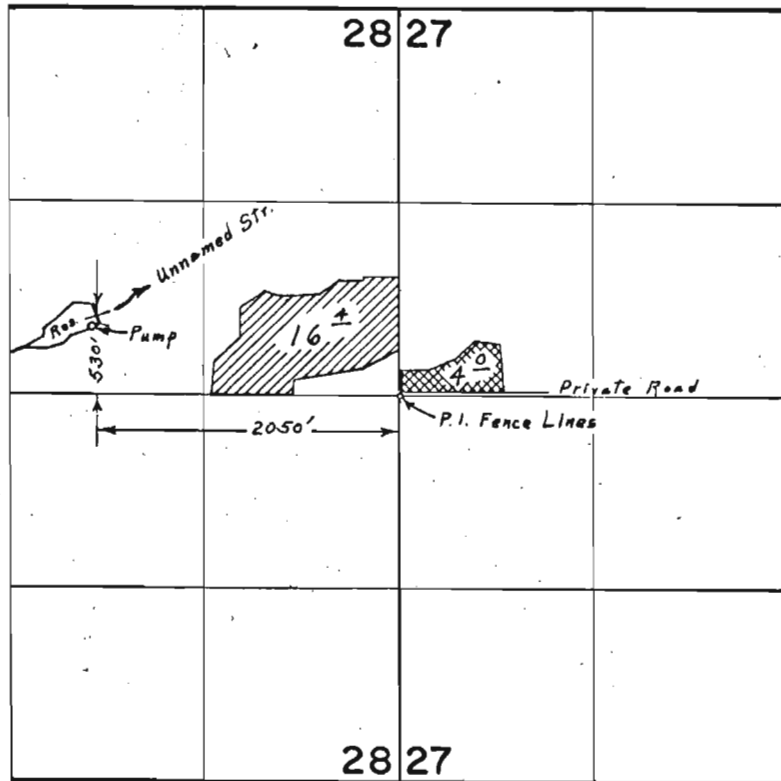

FINAL PROOF SURVEY UNDER

R-40502 R-4582
 40503 30447
 Application No. 42435 Permit No. 31750

IN NAME OF

CARL PIERSON

Surveyed Sept. 14, 1967, by L. E. Gould