

7281

# MAP

Accompanying Application  
to appropriate authority by Mr.

## VIENTO SCHOOL #1


In Section 34 Twp 31 N - E

March 23, 19

### CERTIFICATE OF SURVEY

I, C. M. Hurlburt of Hood River do hereby certify that this made from notes taken from actual survey made by me 15, 1926. and that it corresponds to the Works described in the accompanying application.

C. M. H.  
#766

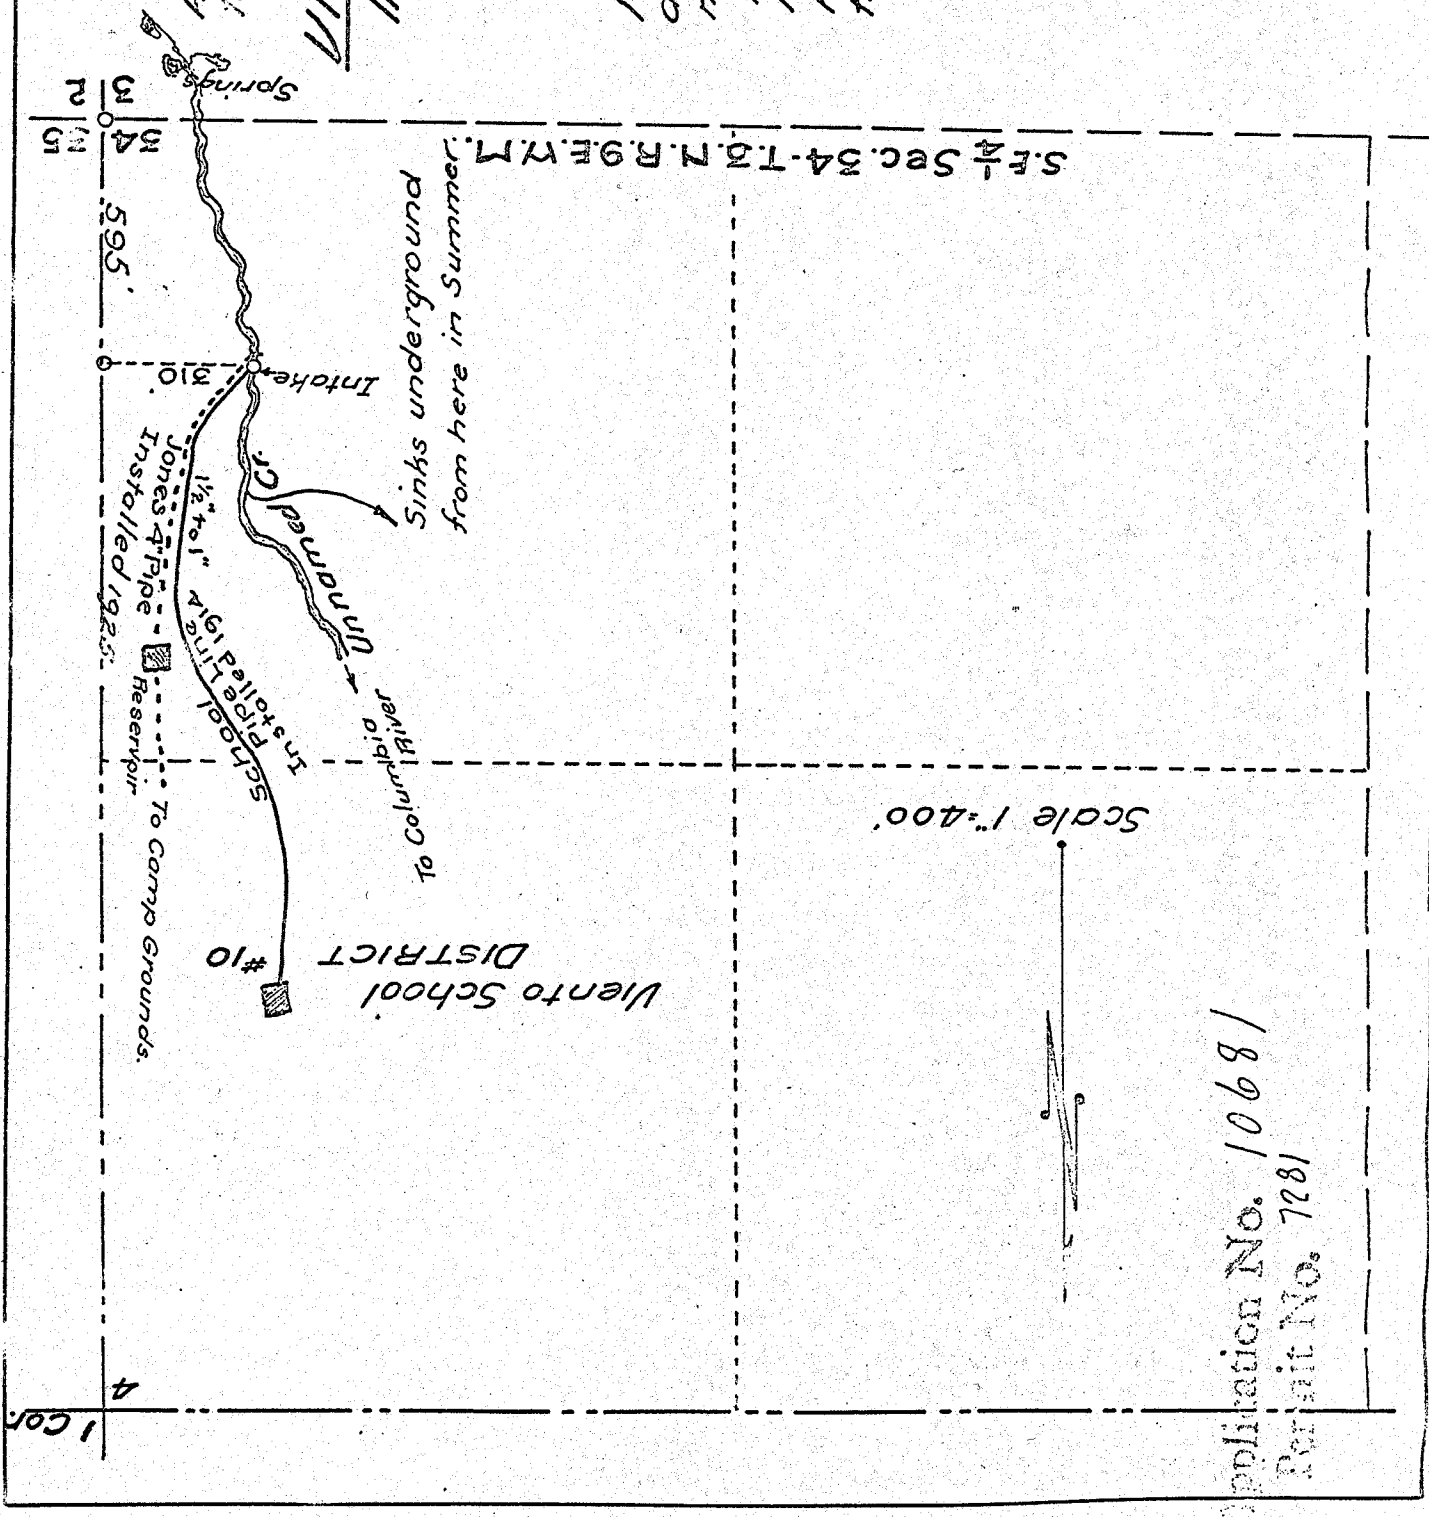

Application No. 1068 /  
Permit No. 7281