


Scale 8" = 1 mi.

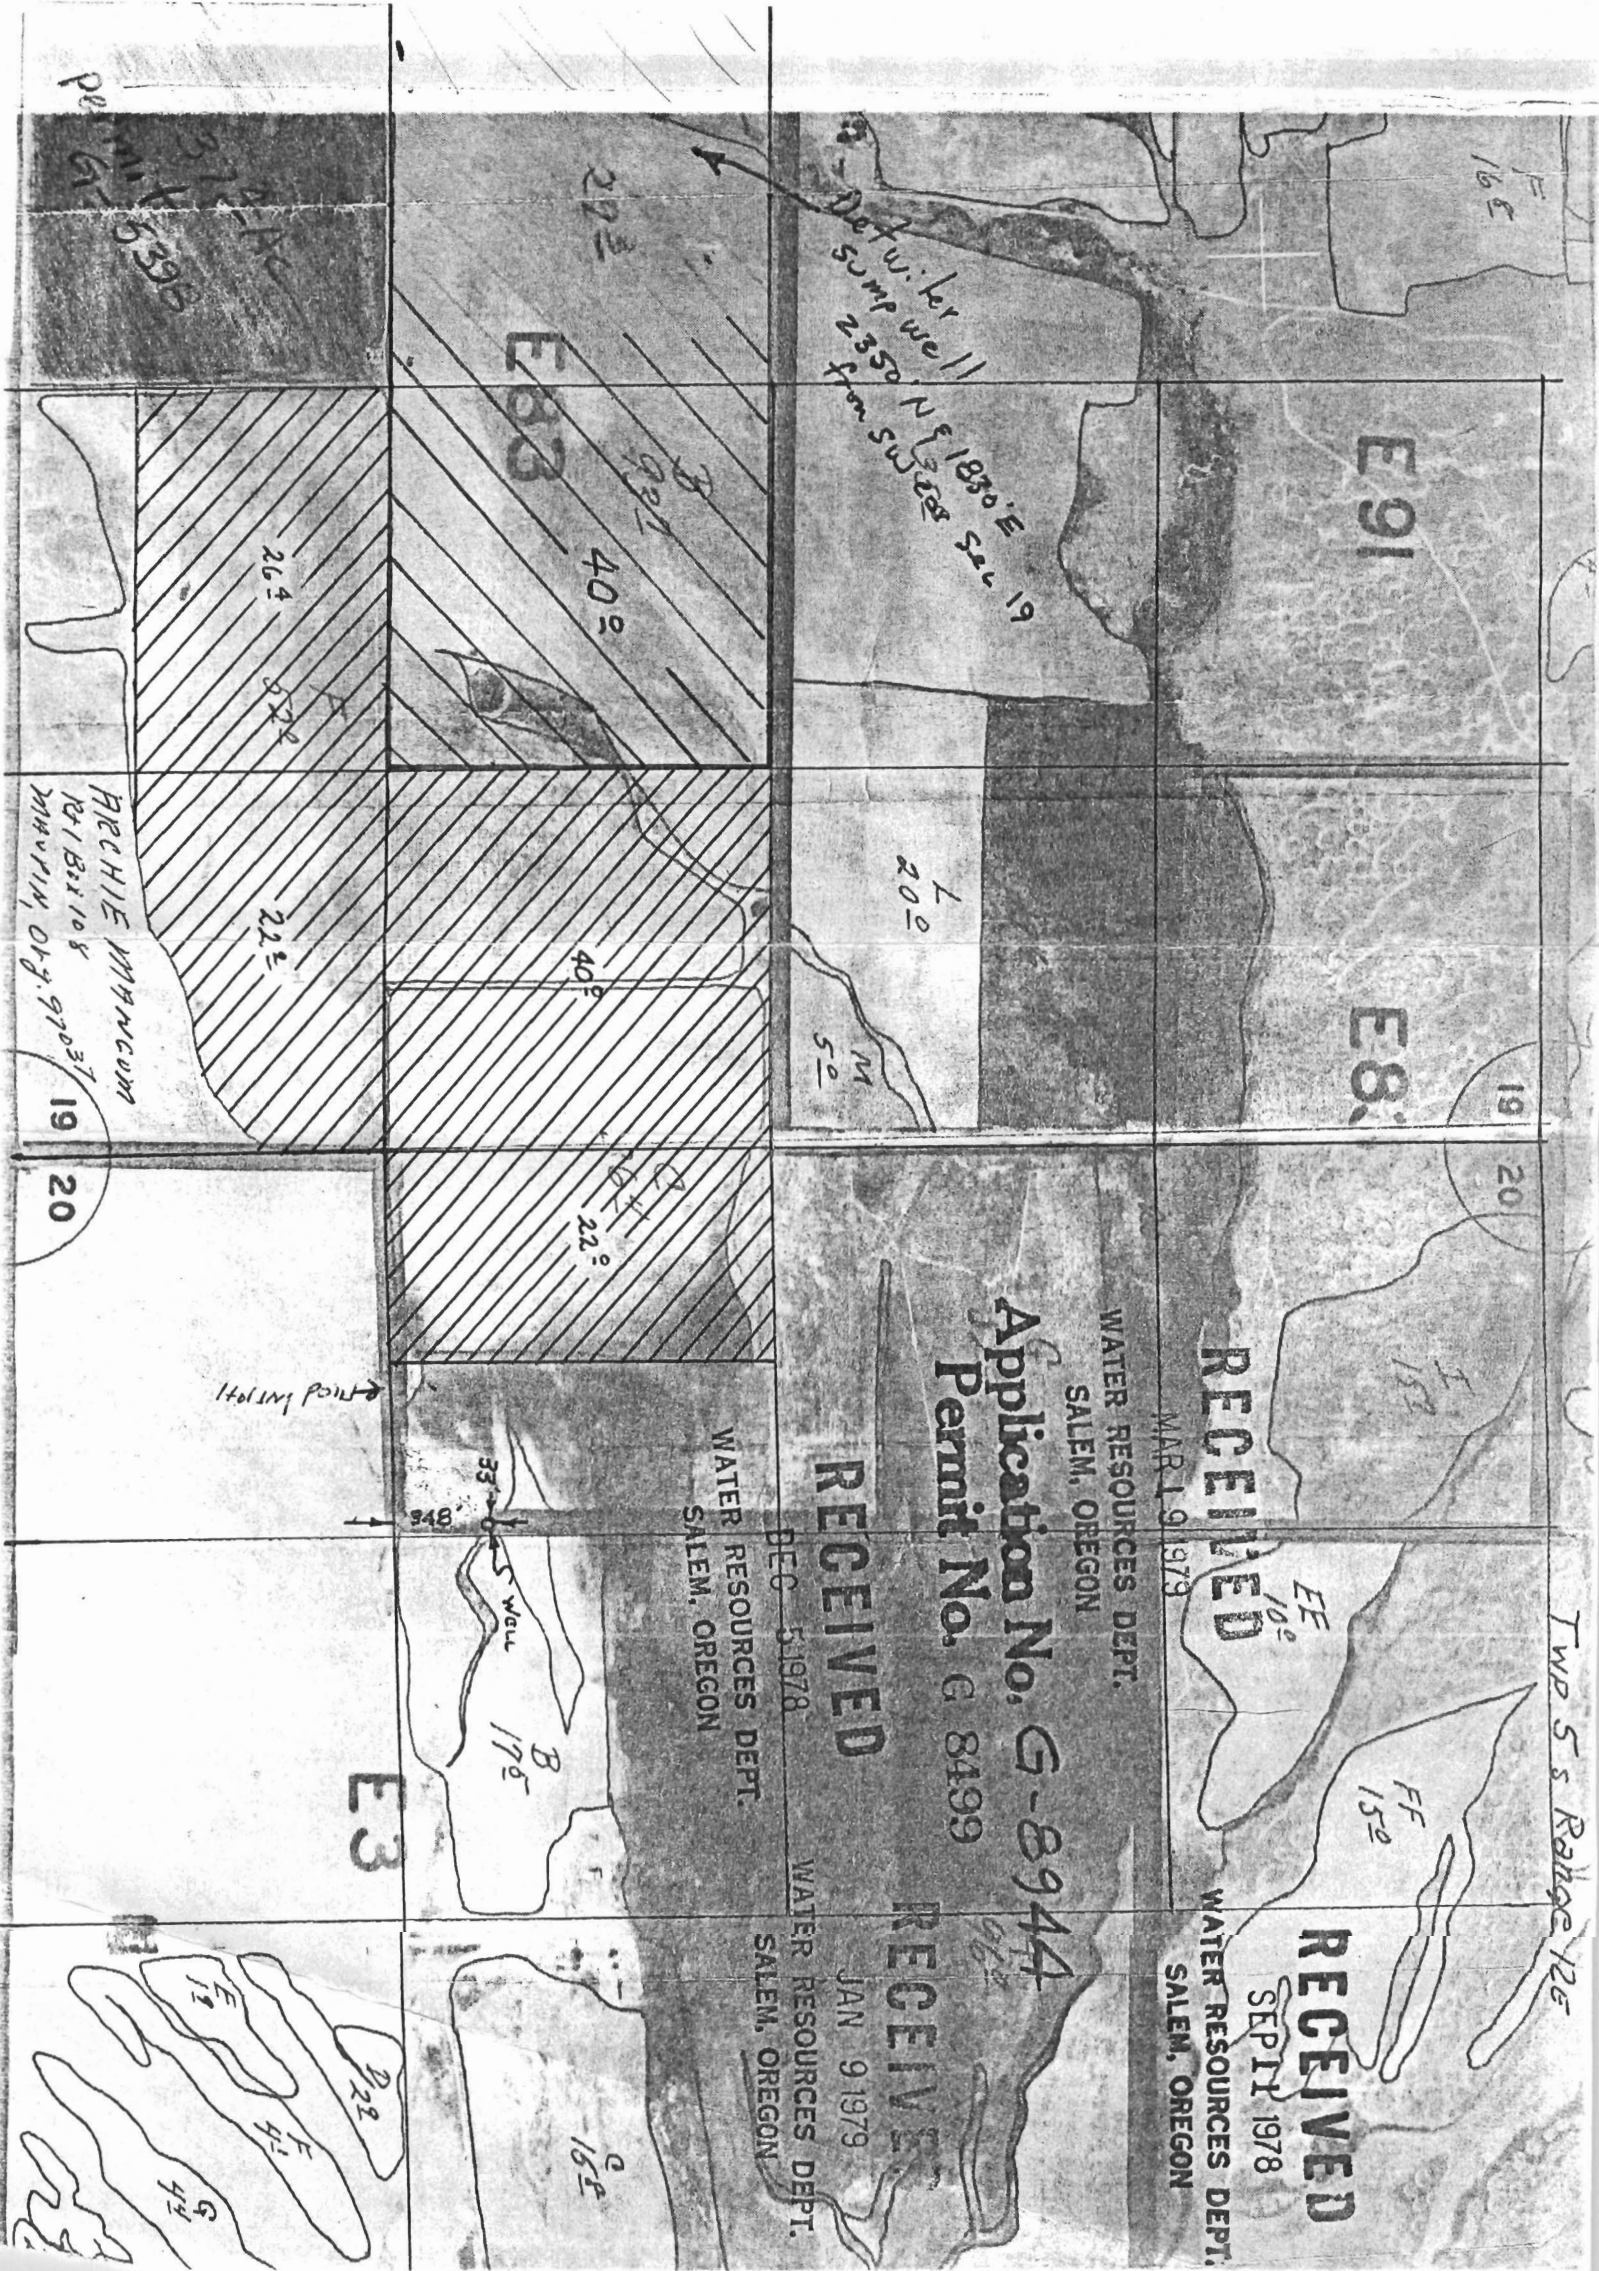

E91

E8

E83

E3

Application No. G-8944
 Permit No. G 8499

RECEIVED

RECEIVED

RECEIVED

RECEIVED

WATER RESOURCES DEPT.
SALEM, OREGON

WATER RESOURCES DEPT.
SALEM, OREGON

WATER RESOURCES DEPT.
SALEM, OREGON

WATER RESOURCES DEPT.
SALEM, OREGON

MAR 19 1979

DEC 5 1978

JAN 9 1979

Det. water well
 2350' N 1830' E
 from SW corner Sec 19

ARCHIE MANCOM
 Rt 1 Box 108
 MAURIN, OR 97037

Twp 5 S Range 12 E

← Filled in 1971

Well

B 175

Q 165

L 20

M 50

40°

22°

931

264

22°

40°

22°

EE 10°

FF 15°

E 11

F 41

G 44

D 22

Permit No. G-8944