


T.16S.R.4W.W.M.

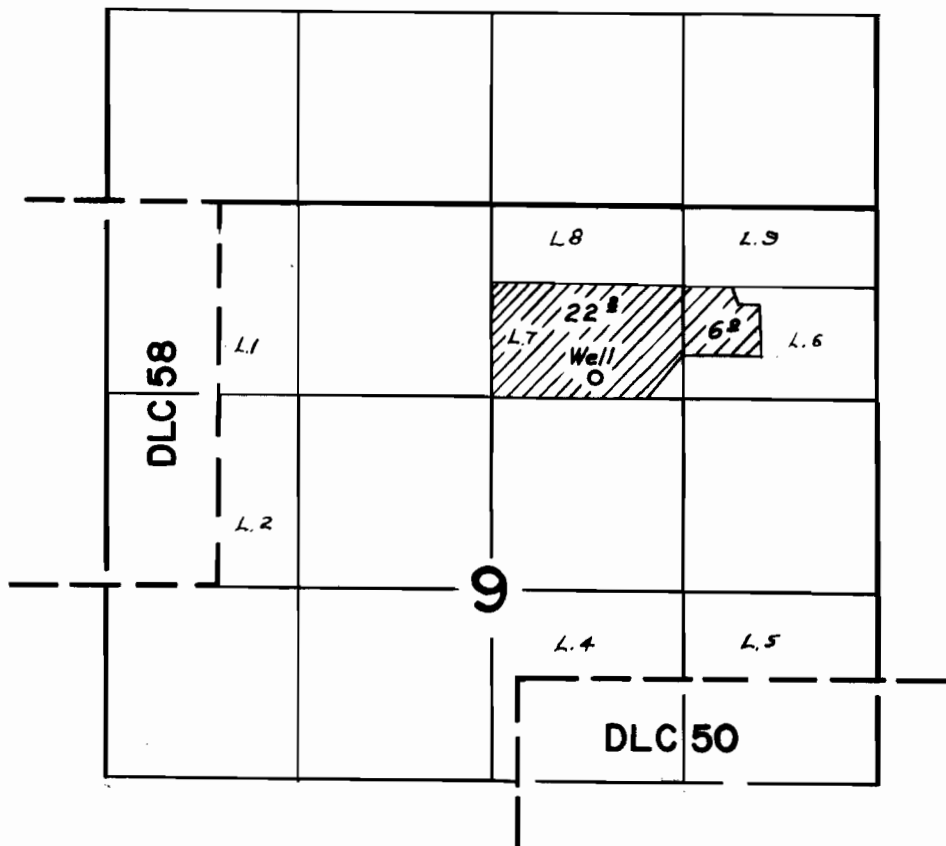

FINAL PROOF SURVEY UNDER

Application No. G-1748 Permit No. G-1599
IN NAME OF

Harold Edwards

Surveyed May 1 1962, by Thomas R. Lauer.