


UNITED STATES
DEPARTMENT OF THE INTERIOR
BUREAU OF LAND MANAGEMENT

SECTION
32

Oregon State Water Filings

TOWNSHIP 10s, RANGE 43E, W. M.

North

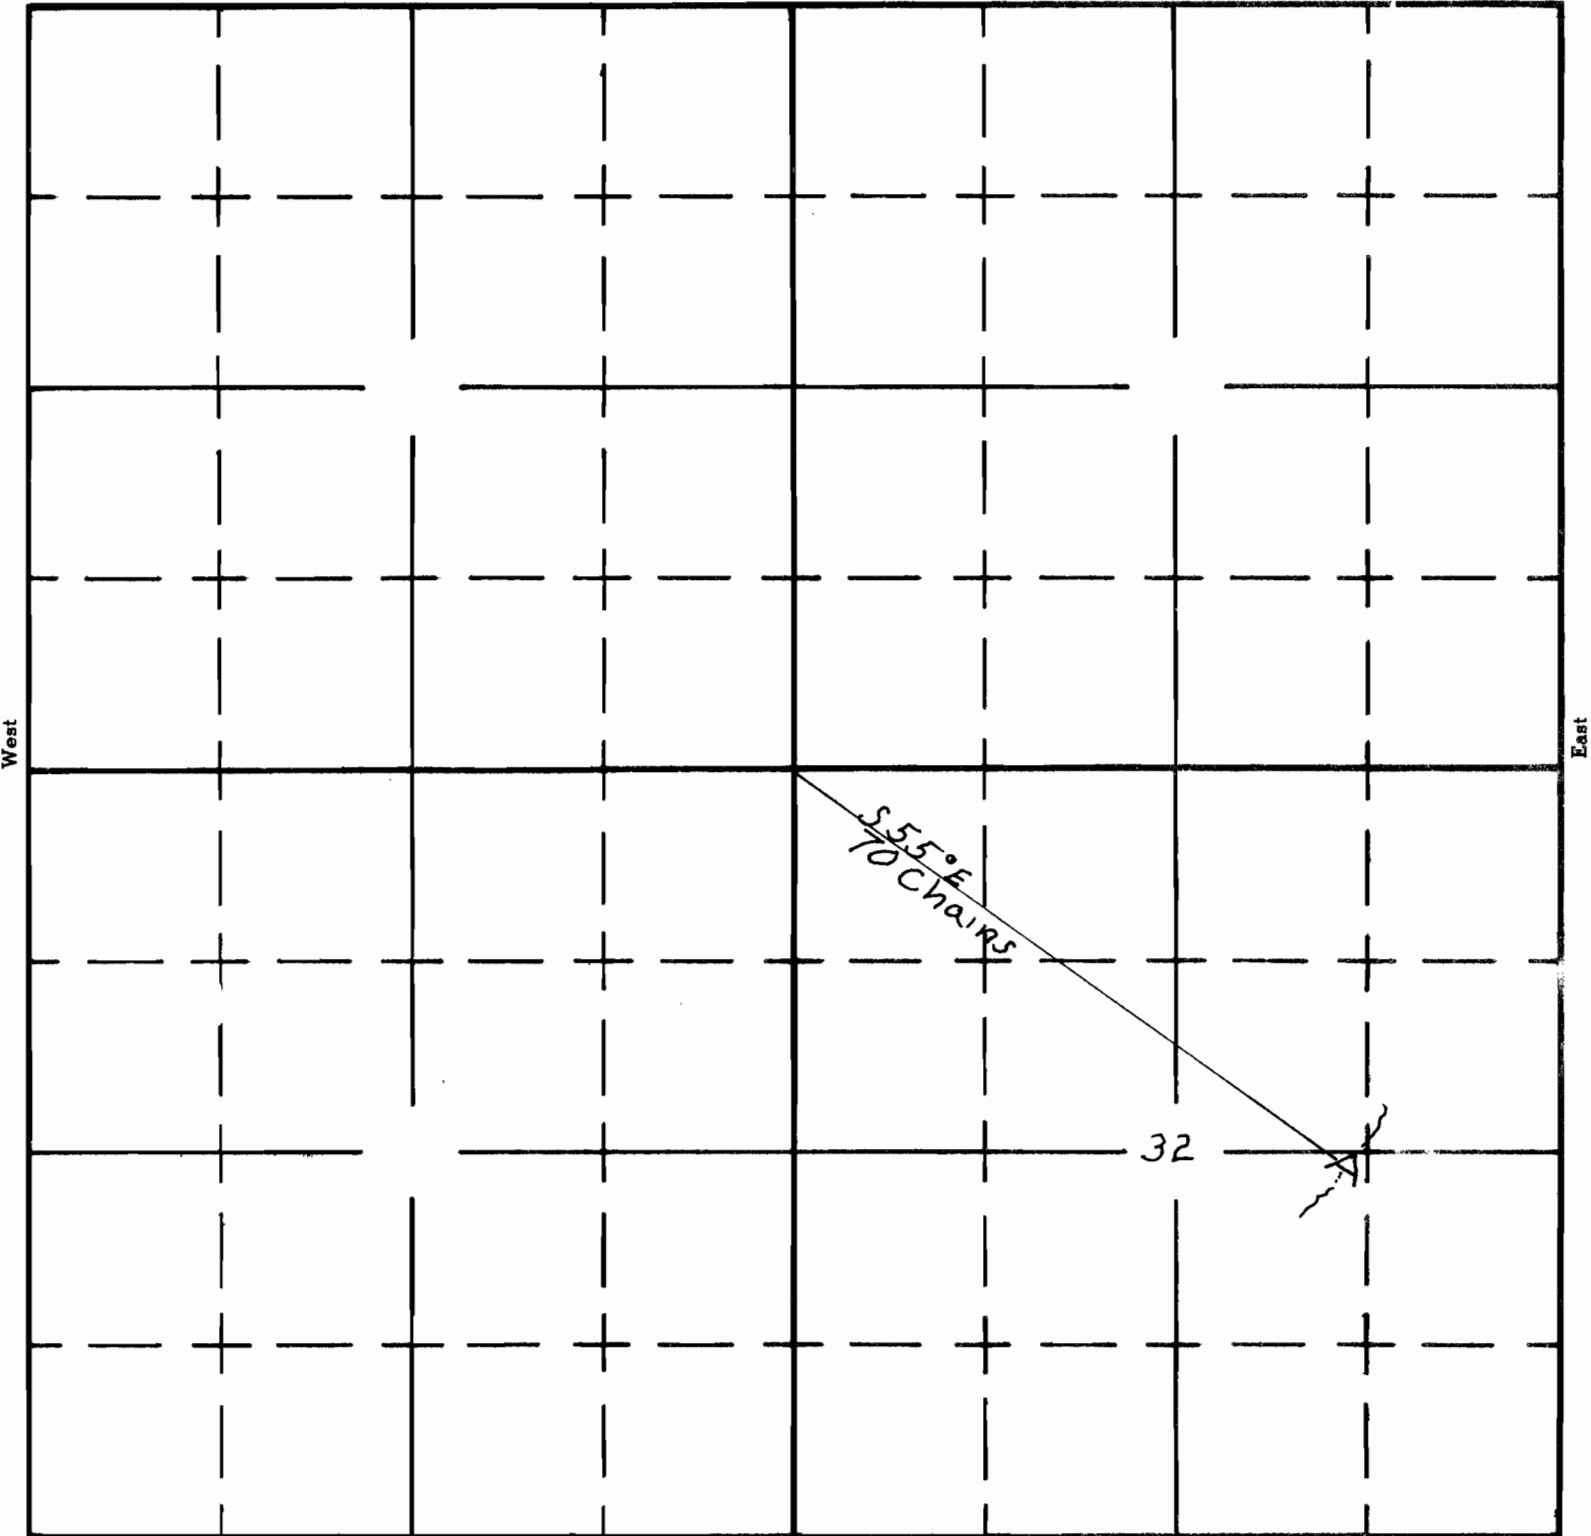

Application No. R-38728
Permit No. R-3275

APPLICATION No.
PERMIT No.