

Form A1-187
March 1961

UNITED STATES
DEPARTMENT OF THE INTERIOR
BUREAU OF LAND MANAGEMENT

SECTION

Oregon State Water Filings


34

TOWNSHIP 32 S., RANGE 47 E., W. M.

SW 4 SW 4

North

BOUNDARY FENCE RESERVOIR

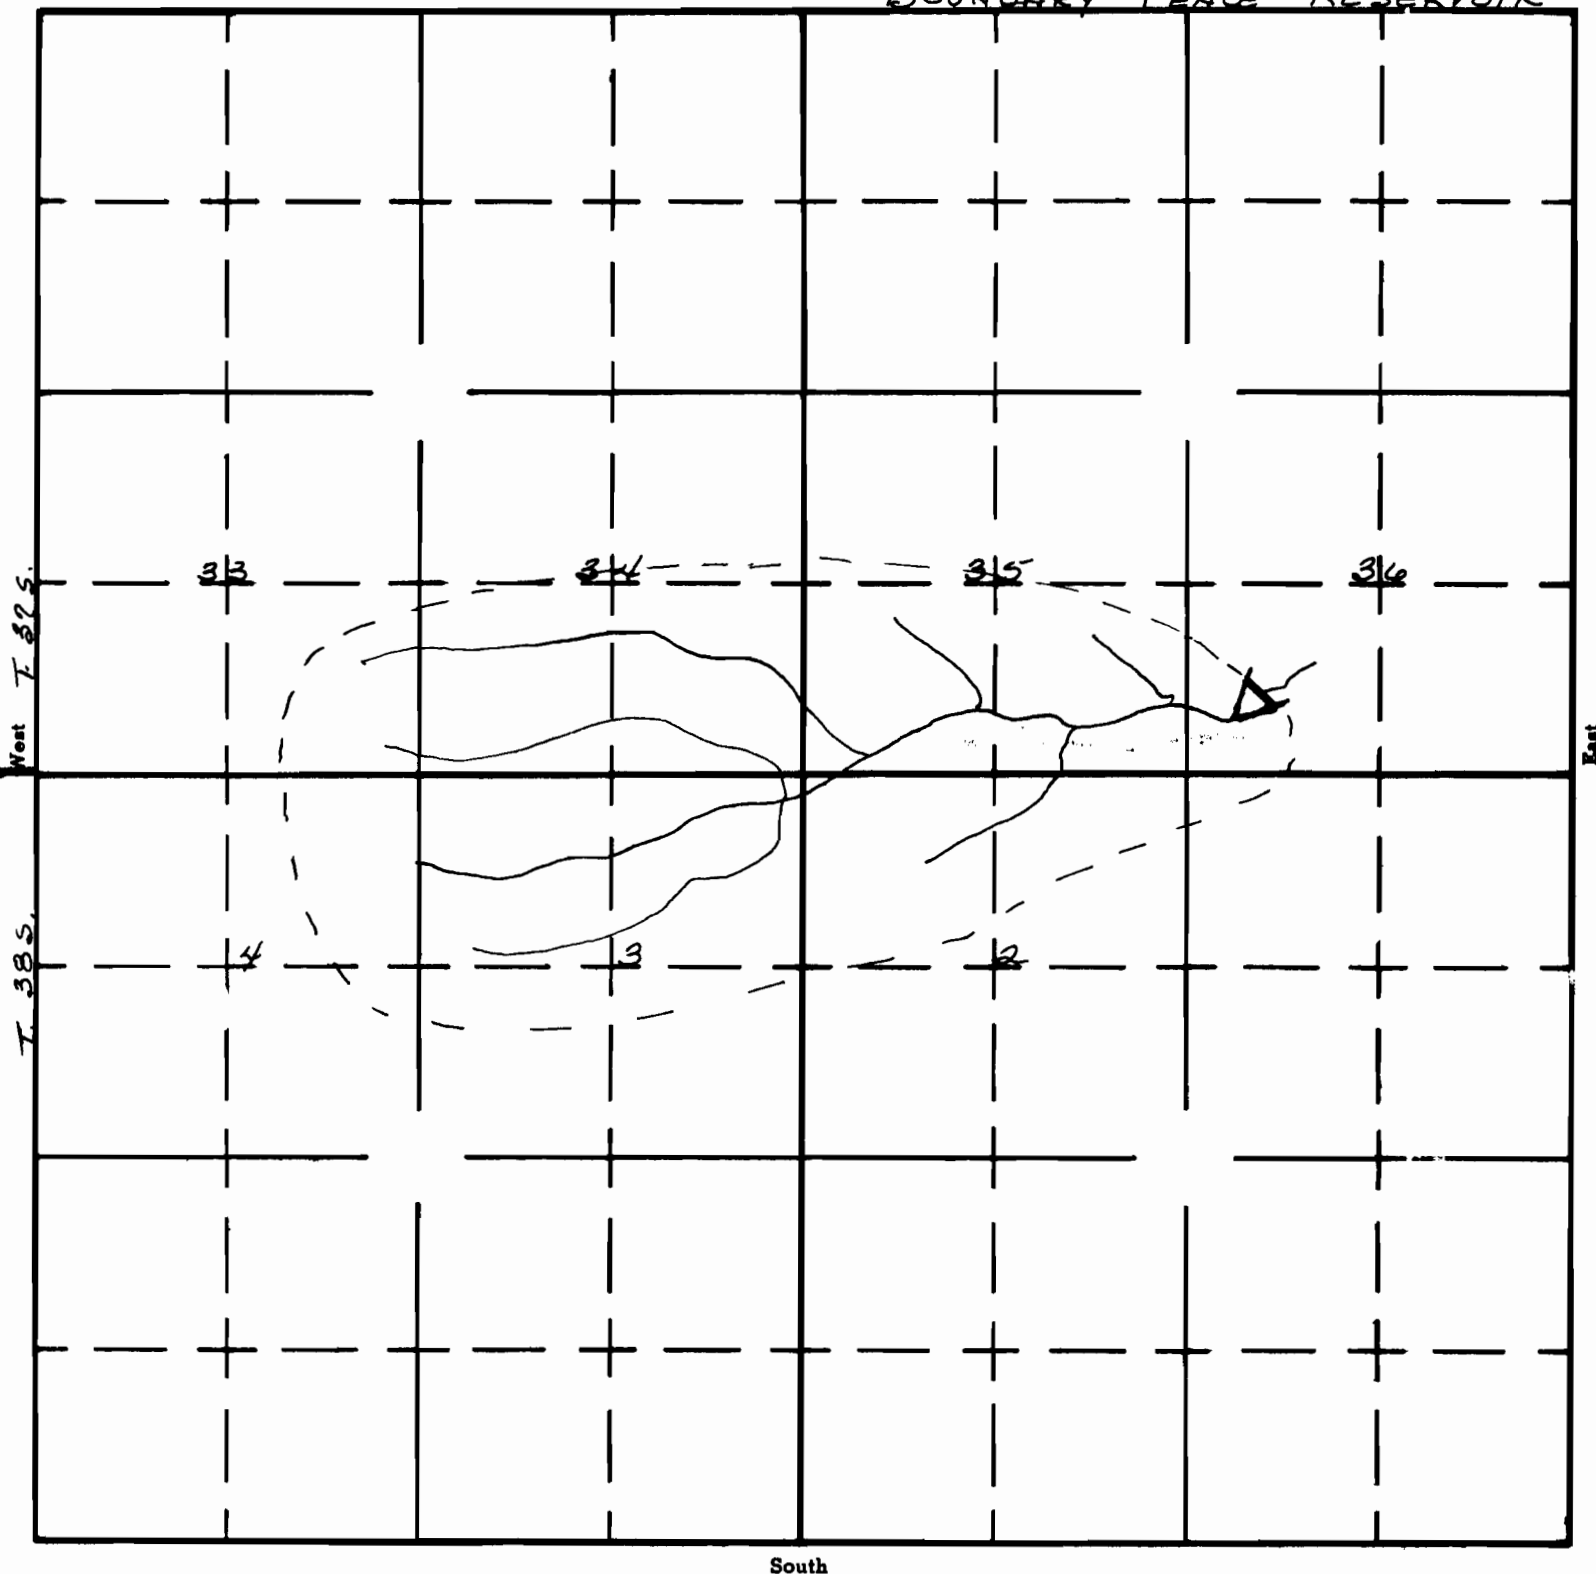

South

APPLICATION No. R-41493

PERMIT No. R-5201