

R-9821

Form OR-010-7300-2
4/83UNITED STATES
DEPARTMENT OF THE INTERIOR
BUREAU OF LAND MANAGEMENT

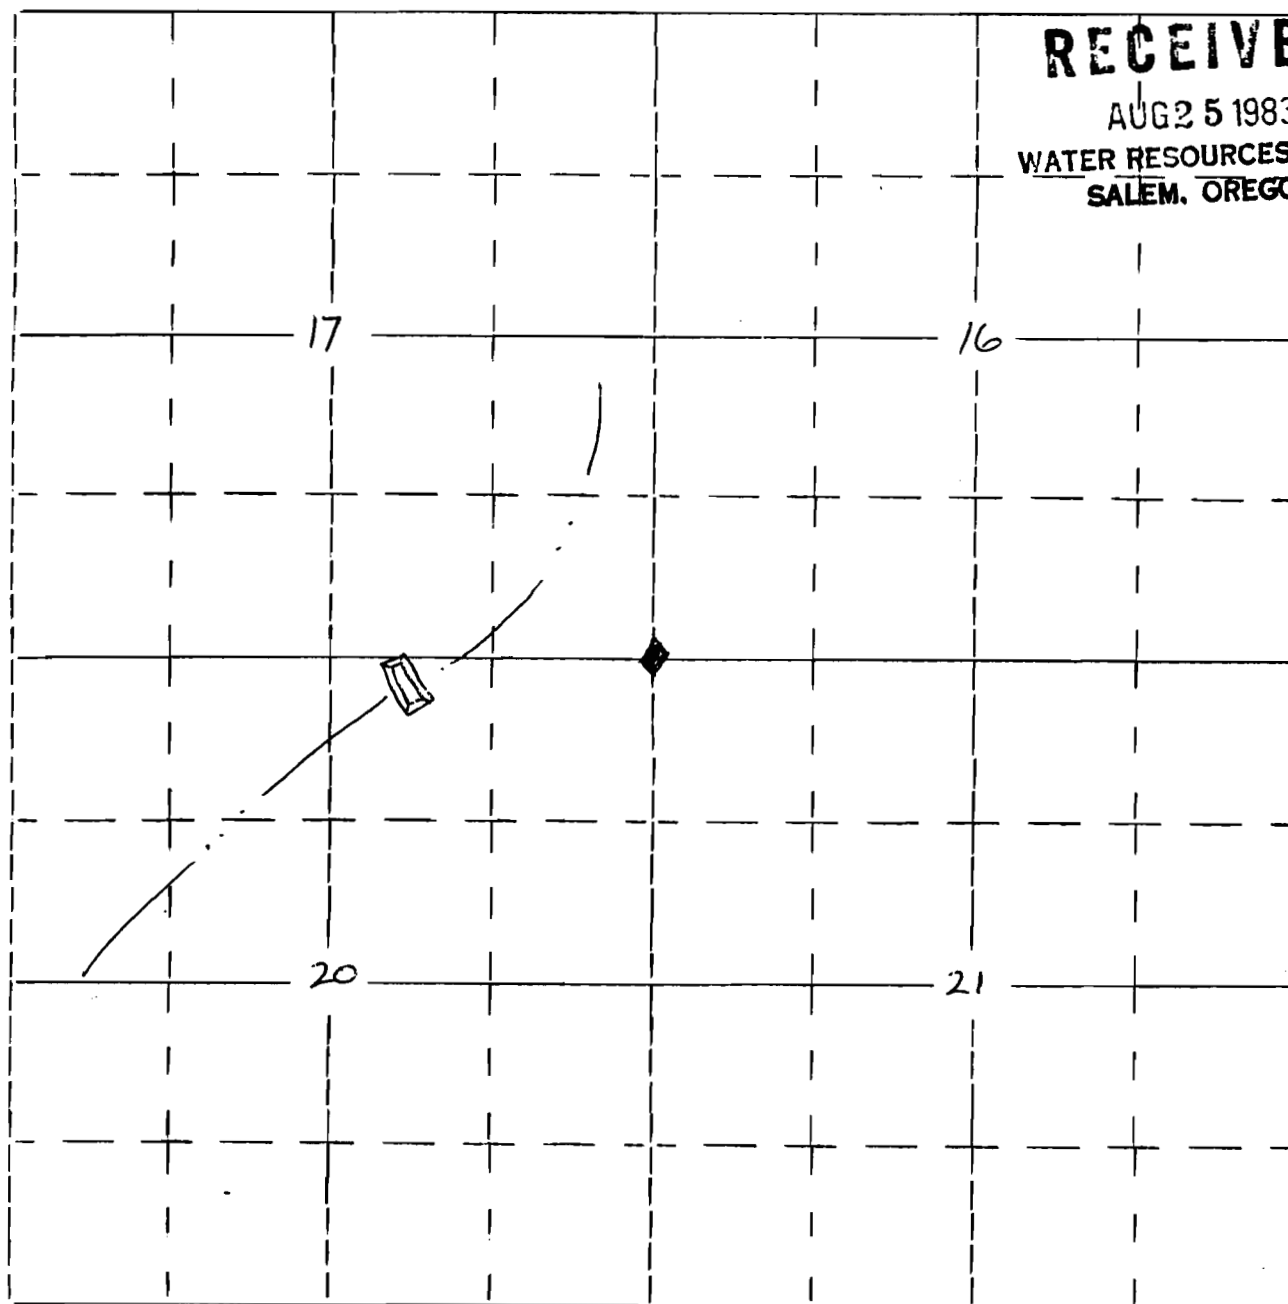
Section

Township 41 S.Appl. No. R-6560916, 17, 20 & 21Range 14 E.Permit No. R 9821

Will. Mer.

RECEIVED

AUG 25 1983

WATER RESOURCES DEPT.
SALEM, OREGON

Waterhole is located 1703' west and 68' south of corner
Common to sections 16, 17, 20 & 21.