



# T. 39S., R. 3W., W.M

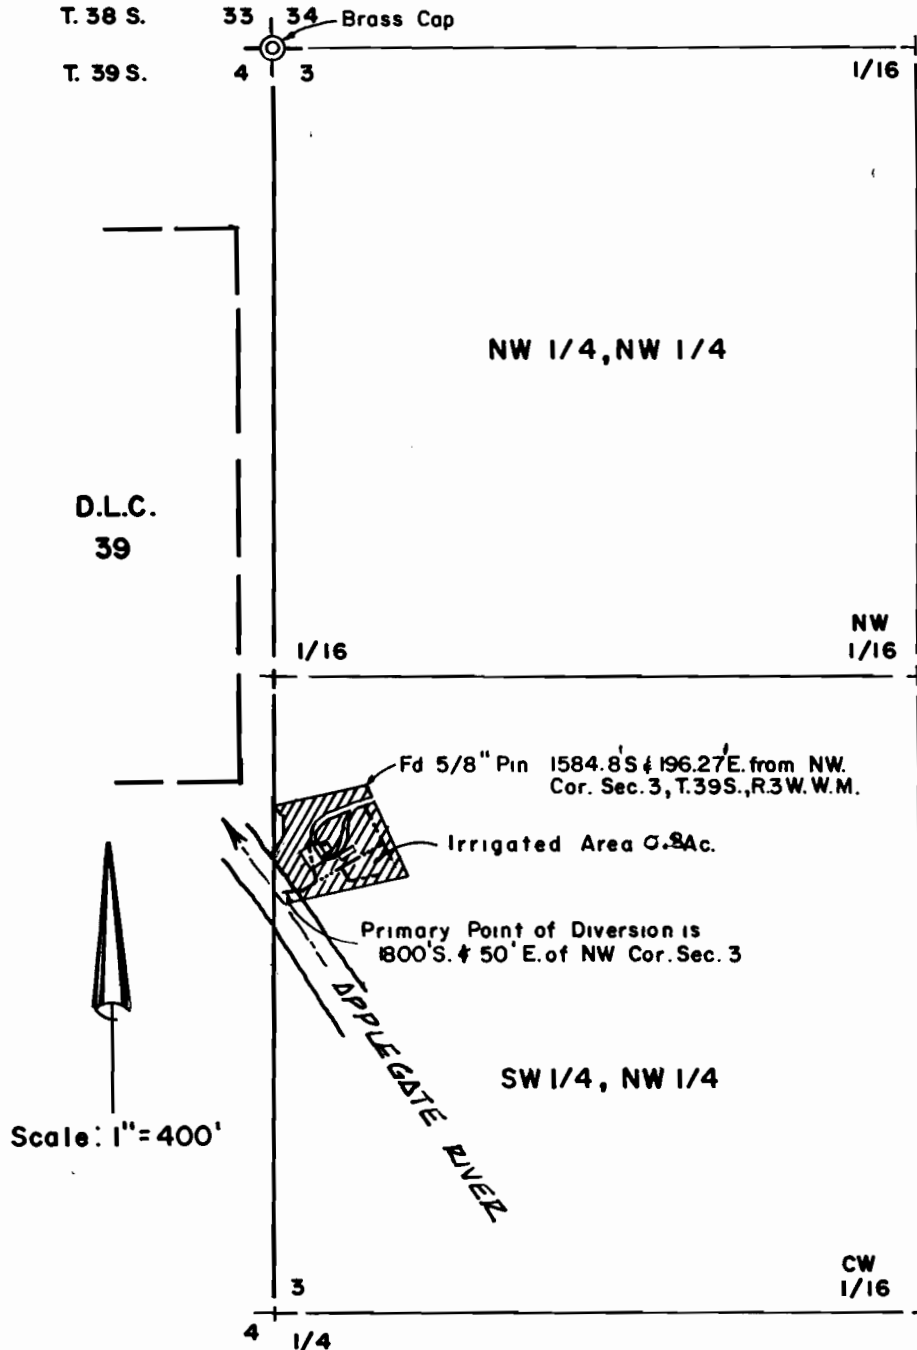

Scale: 1" = 400'

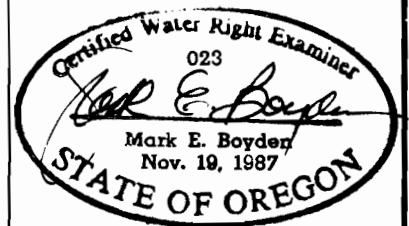

## FINAL PROOF SURVEY

**APPLICANT:**

Carl Carson  
2074 Upper Applegate Rd.  
Jacksonville, Oregon 97530

APPLICATION No. 69586

PERMIT No. 50761