


RECEIVED

T. 8S., R. 42E., W.M.

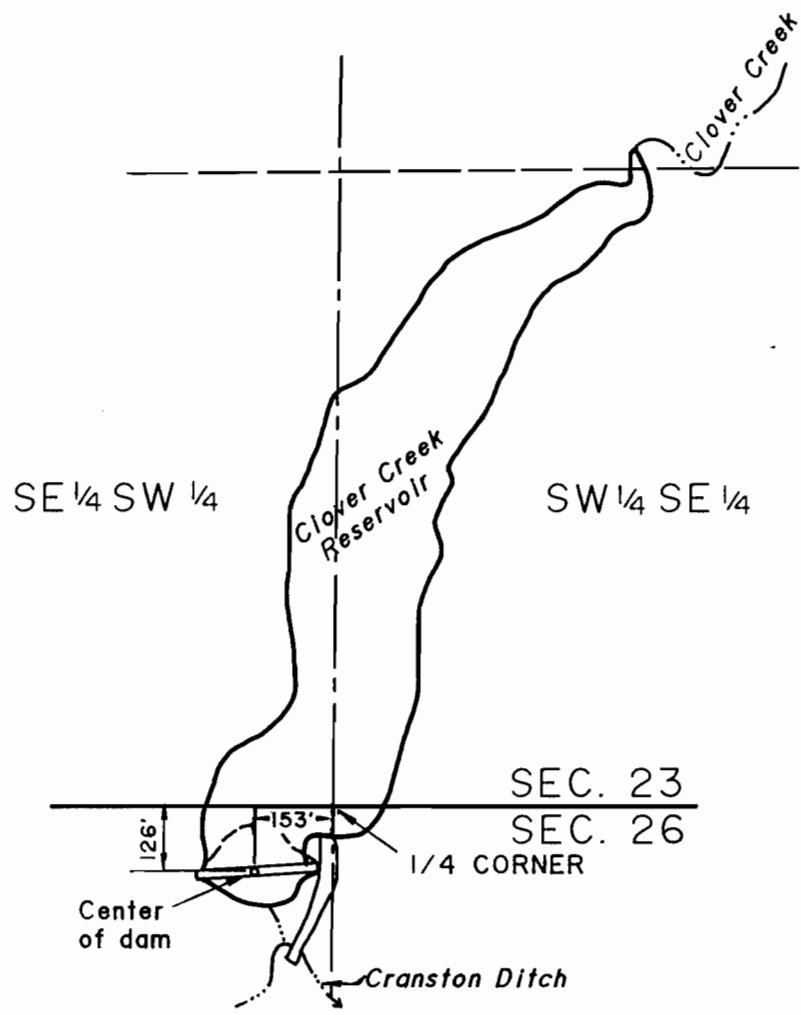

THE PURPOSE OF THIS MAP IS FOR IDENTIFYING THE LOCATION OF THE WATER RIGHT ONLY AND IS NOT INTENDED TO PROVIDE LEGAL DIMENSIONS OF PROPERTY OWNERSHIP LINES.

FINAL PROOF SURVEY

UNDER

70019 51082

Application No. R-69721. Permit No. R-11253.

IN NAME OF

DONALD H. HUBBS, GENERAL PARTNER
POWDER RIVER RANCH

Surveyed..... May 13, 1992

