

TOWNSHIP 26 SOUTH, RANGE 4 WEST, W.M.


**RECEIVED**

SECTIONS 10 & 15

JUL 30 1992

WATER RESOURCES DEPT.  
SALEM, OREGON

SCALE:  
1 INCH = 1320 FEET

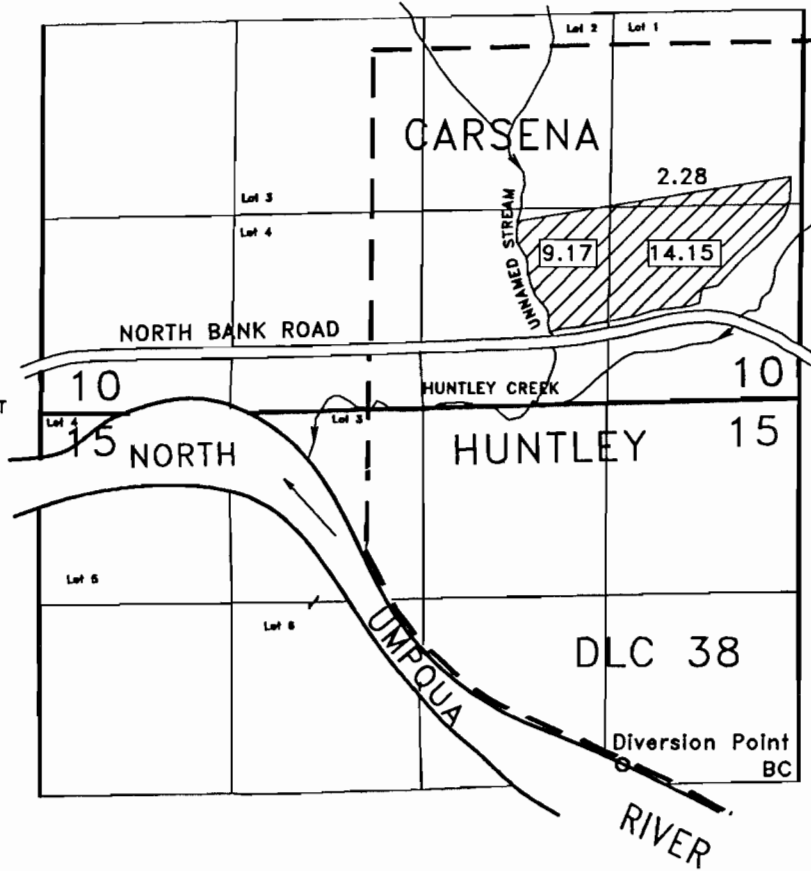

DIVERSION POINT IS LOCATED 150' N. & 1180' W. FROM E1/4 CORNER OF SECTION 15.

# FINAL PROOF SURVEY

for

## A.J. UPDEGRAVE

APPLICATION 70837

PERMIT 51289

THE PURPOSE OF THIS MAP IS TO IDENTIFY THE LOCATION OF THE WATER RIGHT. IT IS NOT INTENDED TO PROVIDE INFORMATION RELATIVE TO THE LOCATION OF PROPERTY OWNERSHIP BOUNDARY LINES.

