


T.15S. R.16E.W.M.

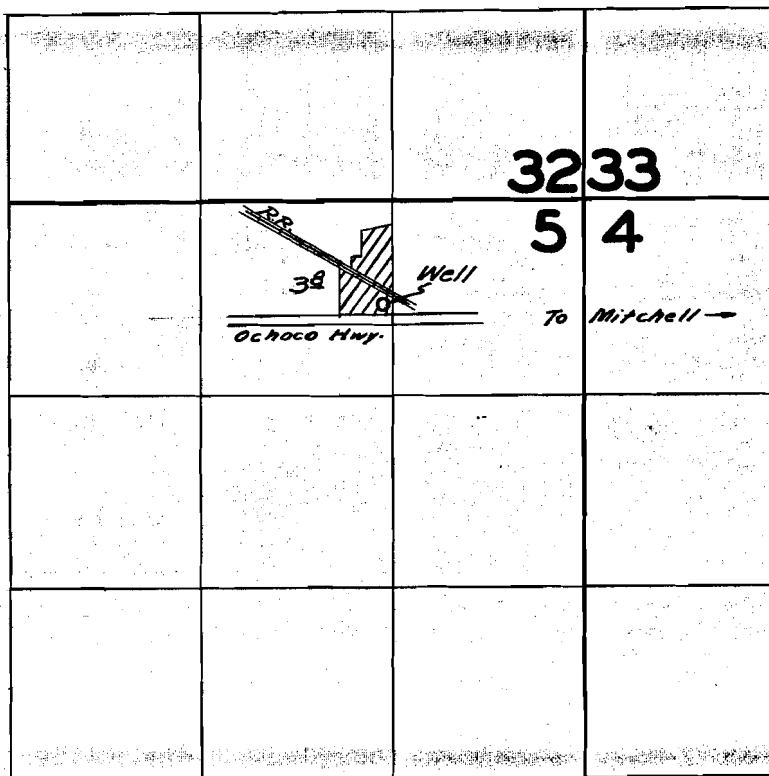

FINAL PROOF SURVEY

UNDER

Application No. 44-170 Permit No. 44-163

IN NAME OF

G.W. BURNET

Surveyed April 22, 1955, by T. Jones

44-163
DCY-9H-23 C.B.

2-163