
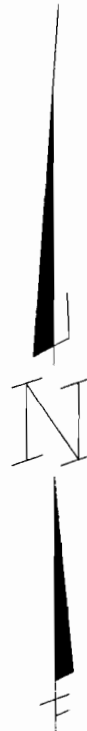


RIVER ROAD

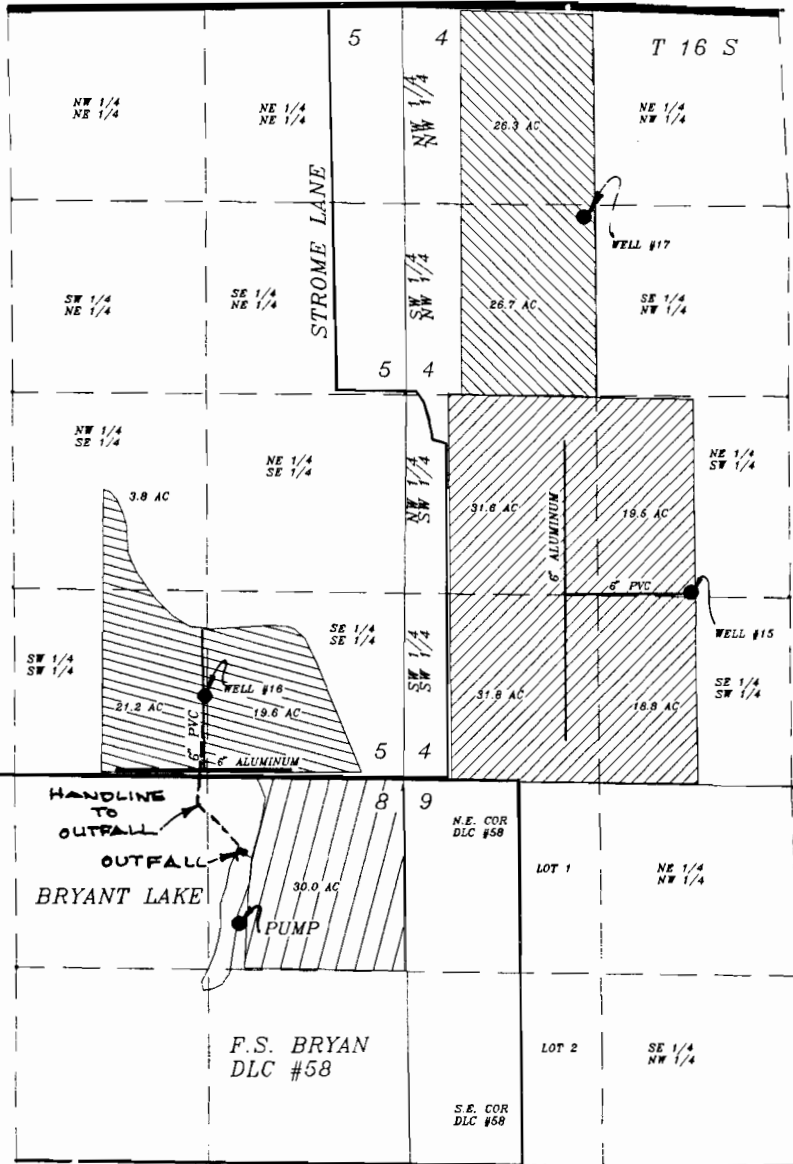

SCALE 1" = 1320'

WELL LOCATION:
 WELL #17 N 49 24' 03" E 1709.50'
 FROM W 1/4 COR SEC 4.
 WELL #15 N 26 35' 12" W 1488.68'
 FROM S 1/4 COR SEC 4.
 WELL #16 N 65 30' 53" E 1444.88'
 FROM S 1/4 COR SEC 5.
 BRYANT LAKE PUMP: SOUTH 1009.68' &
 1140.89' WEST OF N.E. COR. SEC 8.

APPLICATION # C-11885 PERMIT # C-11004

NOTE:
 THIS MAP WAS PREPARED FOR THE
 PURPOSE OF IDENTIFYING THE LOCATION
 OF THE WATER RIGHT ONLY. IT IS
 NOT INTENDED TO PROVIDE DIMENSIONS
 OR LOCATION OF PROPERTY OWNERSHIP
 LINES.

FINAL PROOF SURVEY
 SUPPLEMENTAL IRRIGATION
 FOR STROME-FISHER FARMS, INC.

P.O. BOX 378

JUNCTION CITY, OREGON 97448

PH 998-8000

SECTIONS 4,5,8 IN TOWNSHIP 16 SOUTH, RANGE 4 WEST, W.M.

BY

STEPHEN H. FORD, INC.

1120 BAILEY HILL ROAD #5

EUGENE, OR 97402

PH (503) 344-1852

