


SCALE: 1" = 400'

**SECTION 8, T.2S., R.3E., W.M.
CLACKAMAS COUNTY, OREGON**

This drawing is an exhibit for a Final Proof Survey. It is not a Land Survey. Property lines and/or other lines of occupation shown hereon are not represented by the undersigned to meet accuracy standards of Land Surveys.

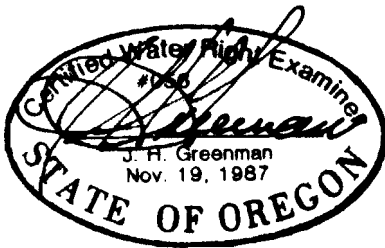

Application No. G-12295

Permit No. G-11168



**HANER, ROSS &
SPORSEEN, INC.**
15 S.E. 82ND DRIVE
GLADSTONE, OREGON 97027

**BURTON & REBECCA ANDERSEN
FINAL PROOF SURVEY
MAP**