
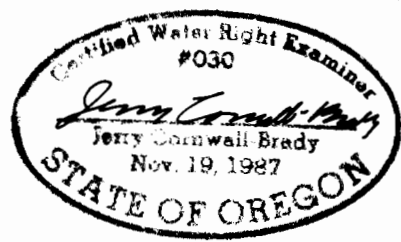


T. 3 N., R. 2 W., W. M.

SECTION 13 & 24

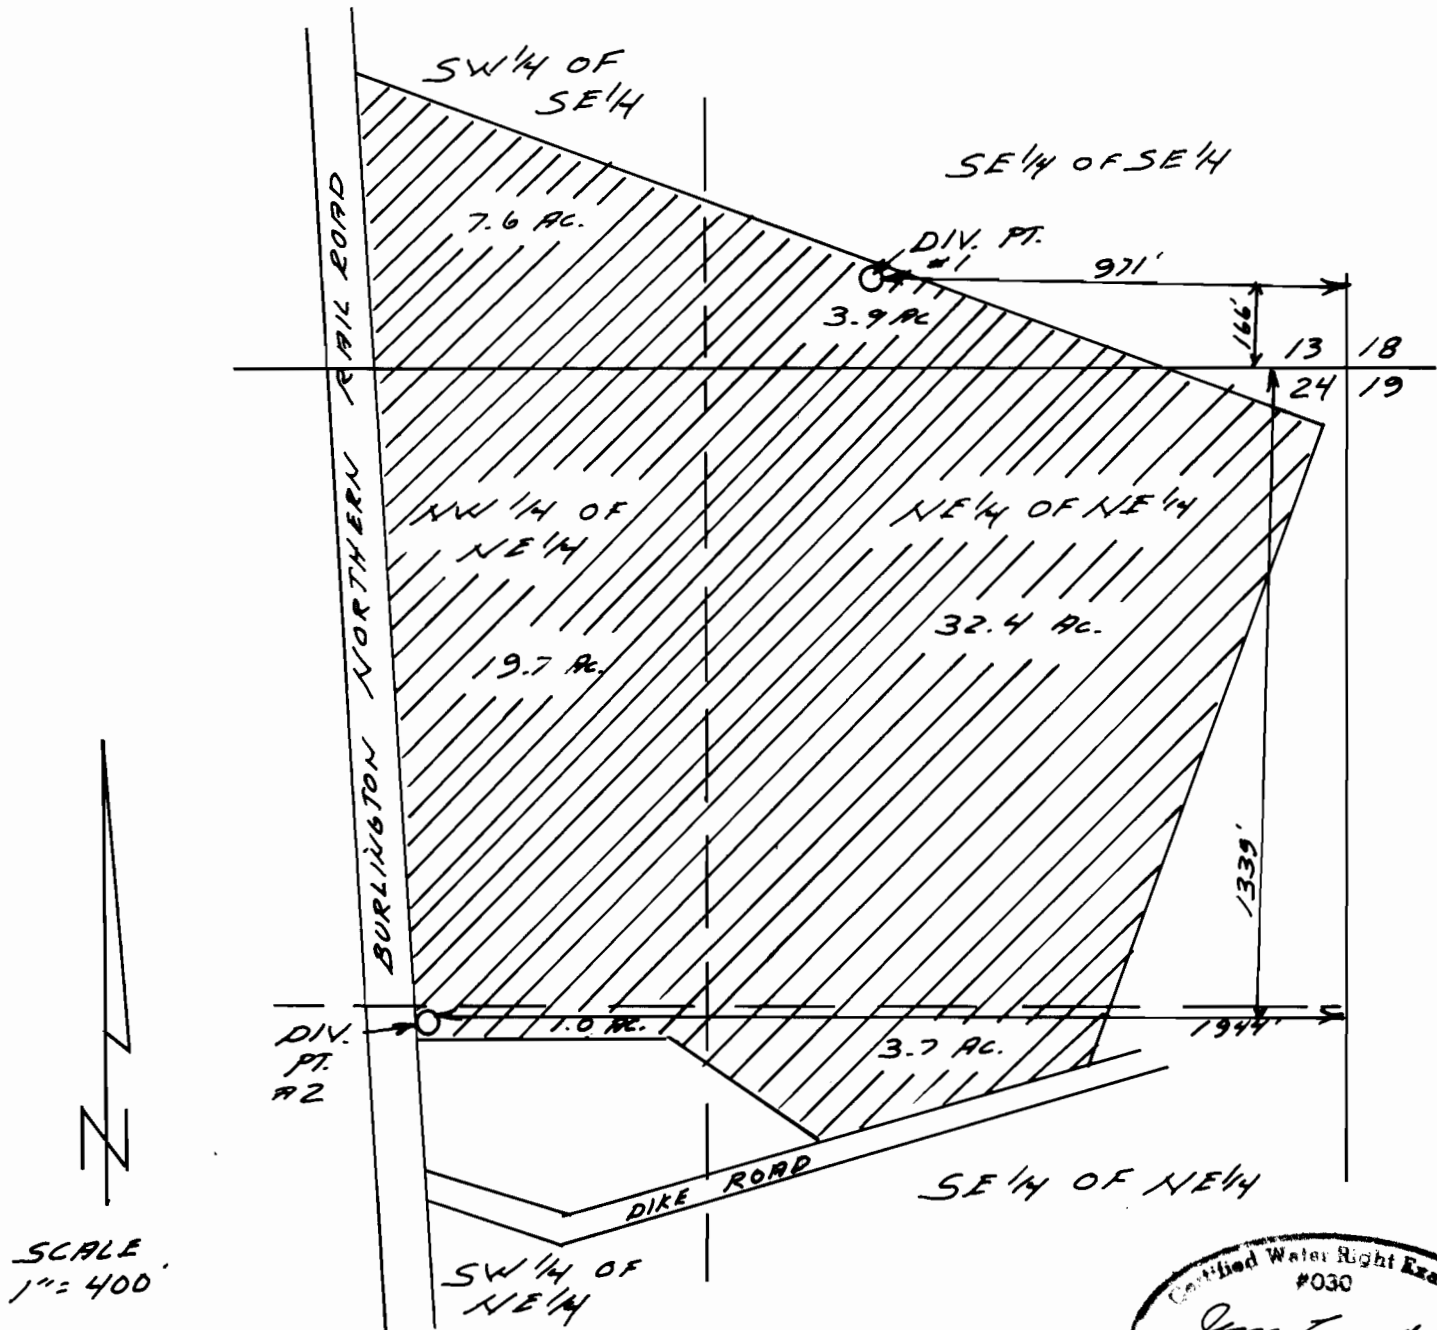

FINAL PROOF SURVEY  
UNDER

APPLICATION No. 69630 PERMIT No. 50679  
IN THE NAME OF

JOSEPH R. & MARIE E. GADOTTI

SURVEYED AUG 24, 1992 BY JERRY CORNWALL-BRADY