


RECEIVED

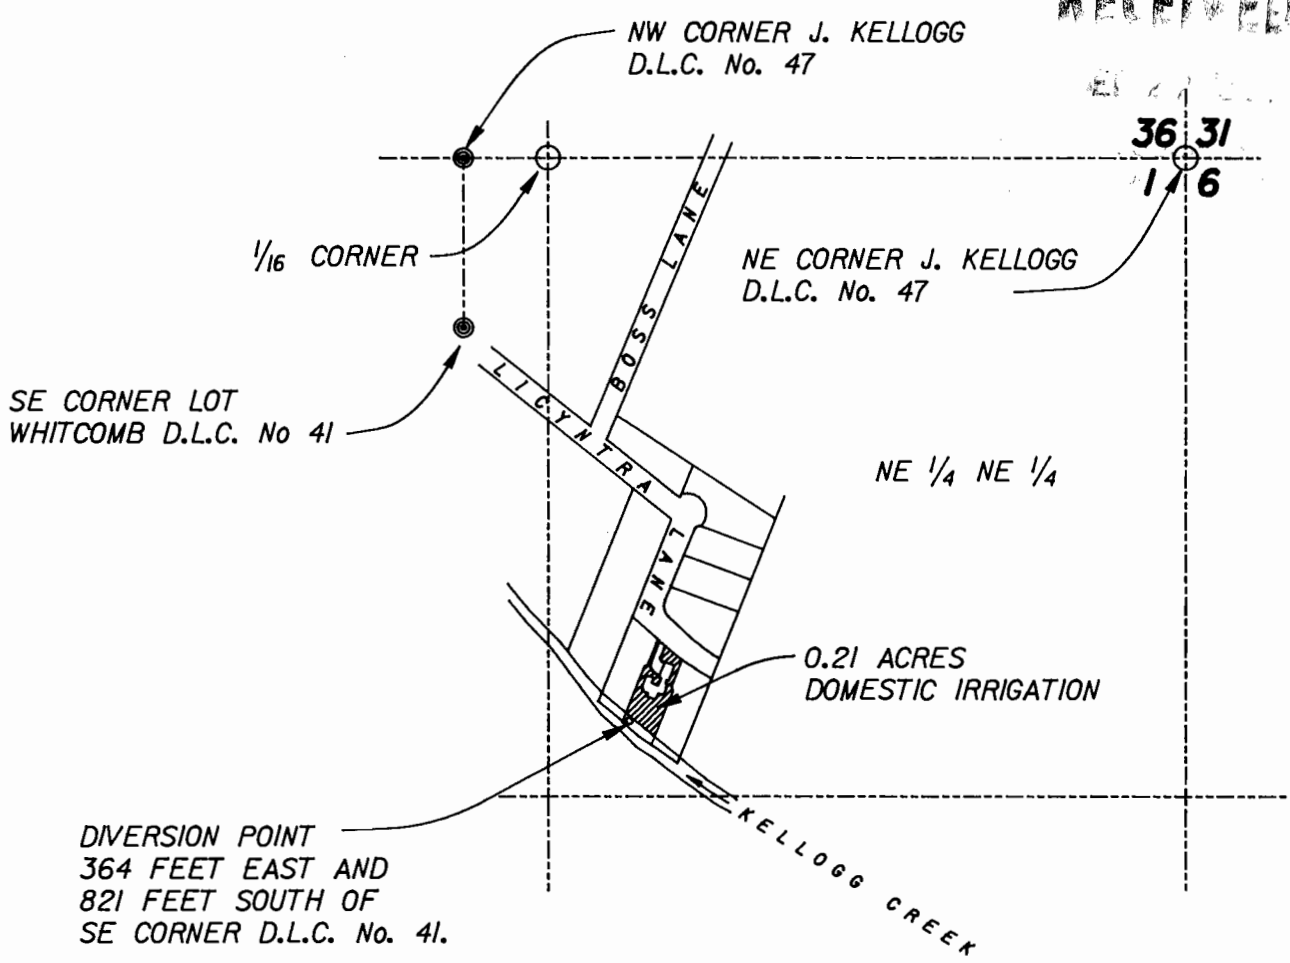

This drawing is an exhibit for a Final Proof Survey.
It is not a Land Survey. Property lines and/or other
lines of occupation shown hereon are not represented
by the undersigned to meet accuracy standards of
Land Surveys.




SCALE: 1" = 400'

Certified Water Right Examiner
296 WRE
George Blathney
George B. Cathey
Nov. 19, 1991
STATE OF OREGON
9-15-92

SECTION 1, T.2S., R.1E., W.M.
CLACKAMAS COUNTY, OREGON

Application No. 70631
Permit No. 51309

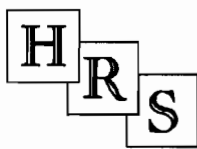

**HANER, ROSS &
SPORSEEN, INC.**
15 S.E. 82ND DRIVE
GLADSTONE, OREGON 97027

**GERARD J. DOERING
FINAL PROOF SURVEY MAP**