



T.5S., R.1E., W.M.

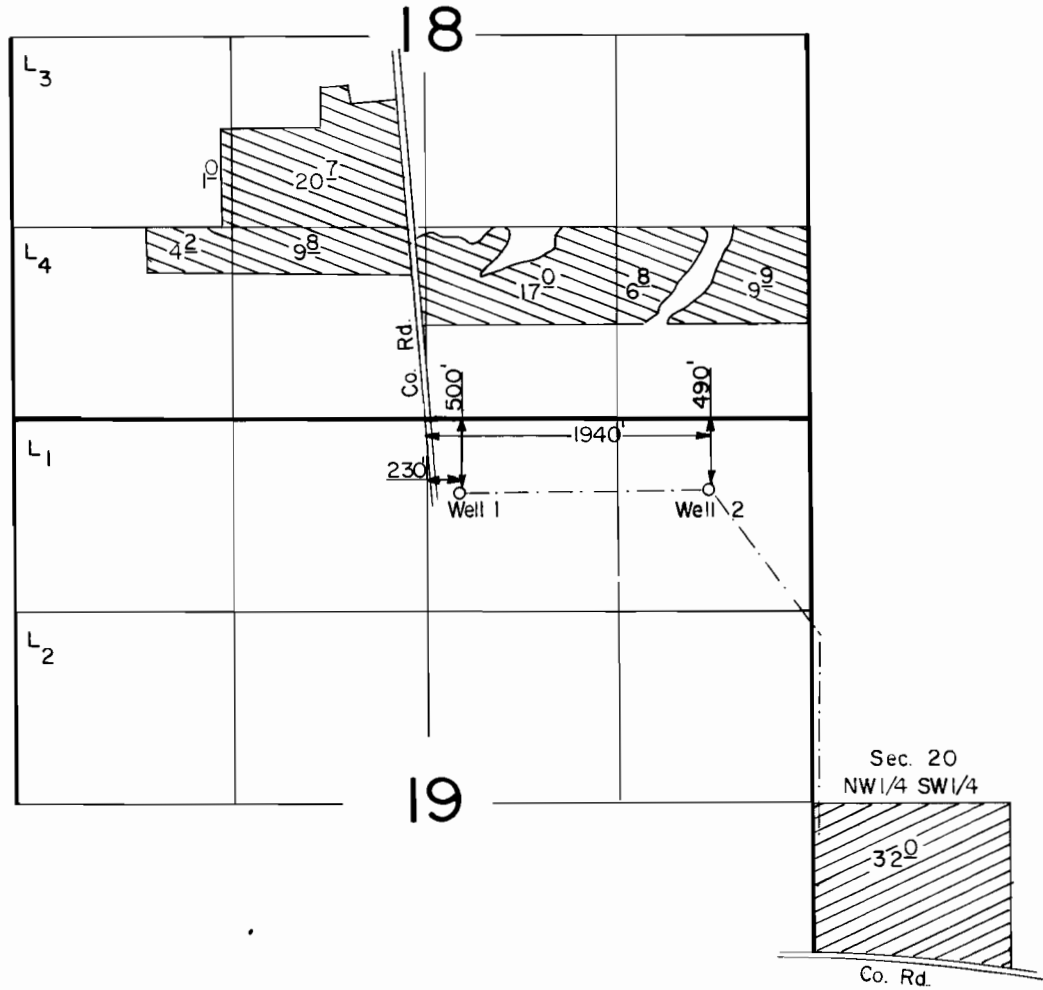

Scale: 1" = 1320'

FINAL PROOF SURVEY
UNDER

G-10142 G- 9367
Application No. G-11202.. Permit No. G-10294....

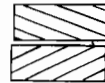

IN NAME OF

HESSEL BIERMA

Surveyed JUNE 17, 1985, by T. Warren
8 25