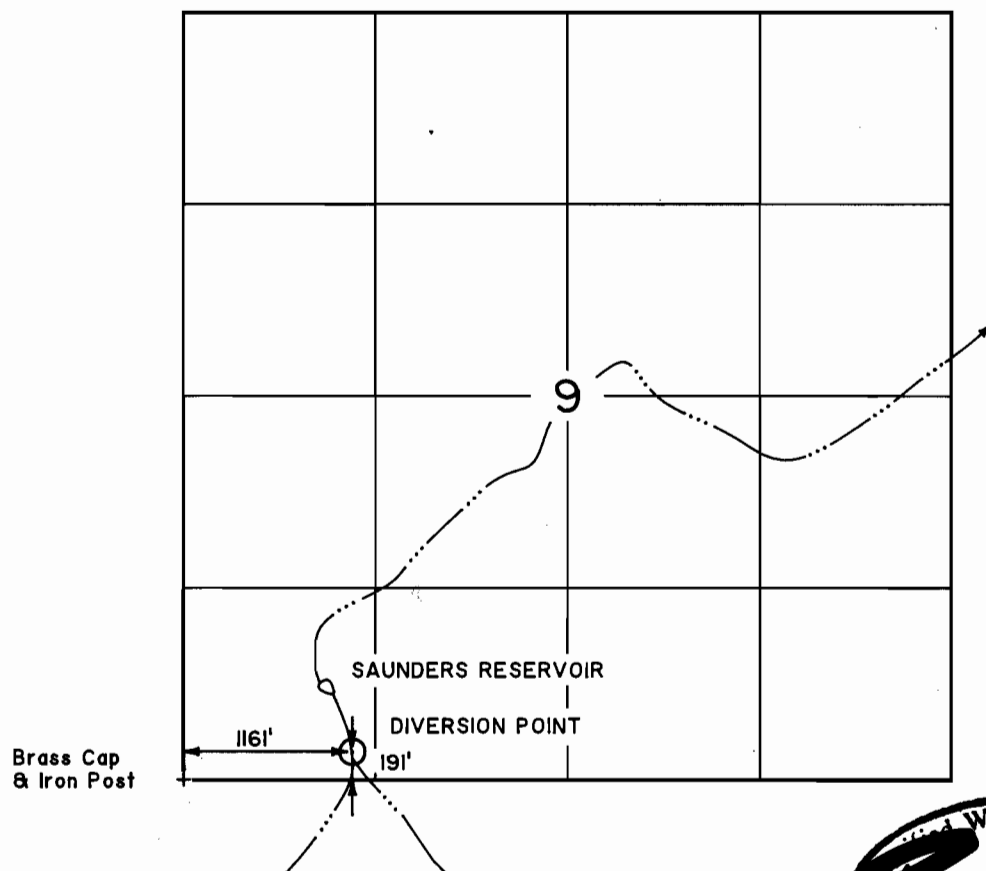


T.30S., R.21E., W.M.

RECEIVED

MAY 15 1996

WATER RESOURCES DEPT.
SALEM, OREGONFINAL PROOF MAP
UNDER

APPLICATION NO. R-47652 PERMIT NO. R-7393

IN NAME OF
UNITED STATES BUREAU OF LAND MANAGEMENT

SURVEYED AUGUST 23, 1995

THE PURPOSE OF THIS MAP IS FOR IDENTIFYING THE LOCATION OF THE WATER RIGHT ONLY AND
IS NOT INTENDED TO PROVIDE LEGAL DIMENSIONS OR LOCATION OF PROPERTY OWNERSHIP LINES.THE TIE WAS DETERMINED BY INVERSE BETWEEN POSITIONS, DERIVED FROM A RESOURCE GRADE GLOBE POSITIONING
SYSTEM, A TRIMBLE PATHFINDER, WITH A POSITIONAL ACCURACY OF 2-5 METERS, 50 PERCENT OF THE TIME.

BLM PROJECT NO. OR-36-010-R-4183

WRE 6141F OREGON

U.S. BUREAU OF LAND MANAGEMENT-OSO
BRANCH OF CADASTRAL SURVEY
LETTER OF AUTHORIZATION
DATED: JUNE 7, 1995EXECUTED BY:
RICHARD L. JOHNSON, PLS, CWRE
P.O. BOX 2965
PORTLAND, OREGON 97208