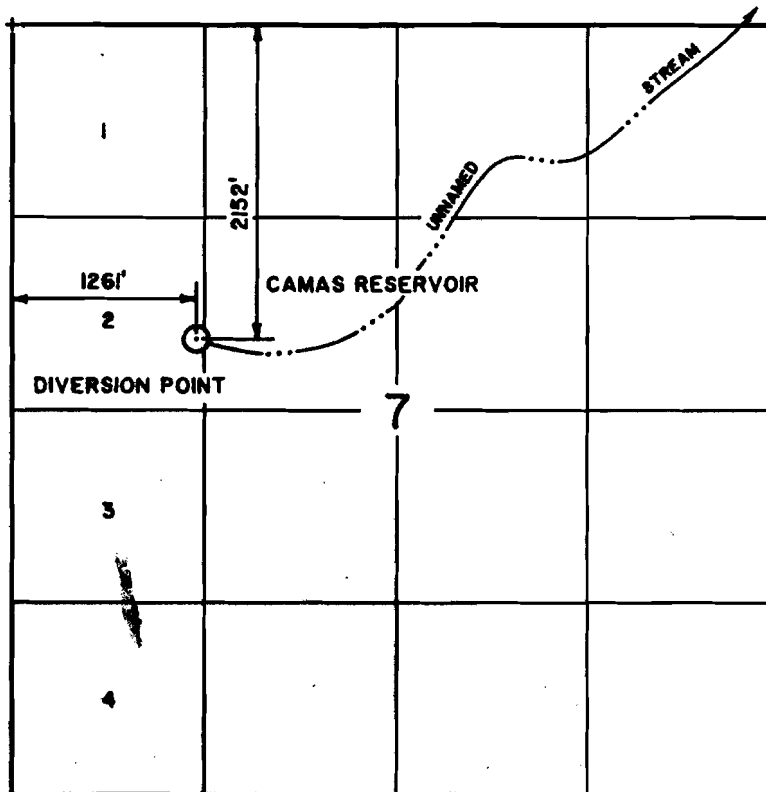


T.39S., R.23E., W.M.

BRASS CAP &
IRON PIPE**RECEIVED**


MAY 15 1996

WATER RESOURCES DEPT.
SALEM, OREGON

1" = 1320'

FINAL PROOF MAP

UNDER

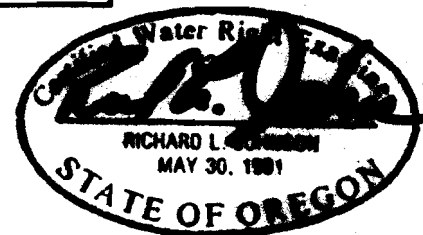

APPLICATION NO. R-71328 PERMIT NO. R-11366

IN NAME OF
UNITED STATES BUREAU OF LAND MANAGEMENT

SURVEYED AUGUST 22, 1995

THE PURPOSE OF THIS MAP IS FOR IDENTIFYING THE LOCATION OF THE WATER RIGHT ONLY AND
IS NOT INTENDED TO PROVIDE LEGAL DIMENSIONS OR LOCATION OF PROPERTY OWNERSHIP LINES.

BLM PROJECT NO. OR-010-6152

WRE 6136F OREGON

U.S. BUREAU OF LAND MANAGEMENT-OSO
BRANCH OF CADASTRAL SURVEY
LETTER OF AUTHORIZATION
DATED: JUNE 7, 1995

EXECUTED BY:
RICHARD L. JOHNSON, PLS, CURE
P.O. BOX 2965
PORTLAND, OREGON 97208