


Plot for Water Filing

Walter O. Lithgow and Lulu Lithgow

Sec. 17 T13S-R14E W.M.

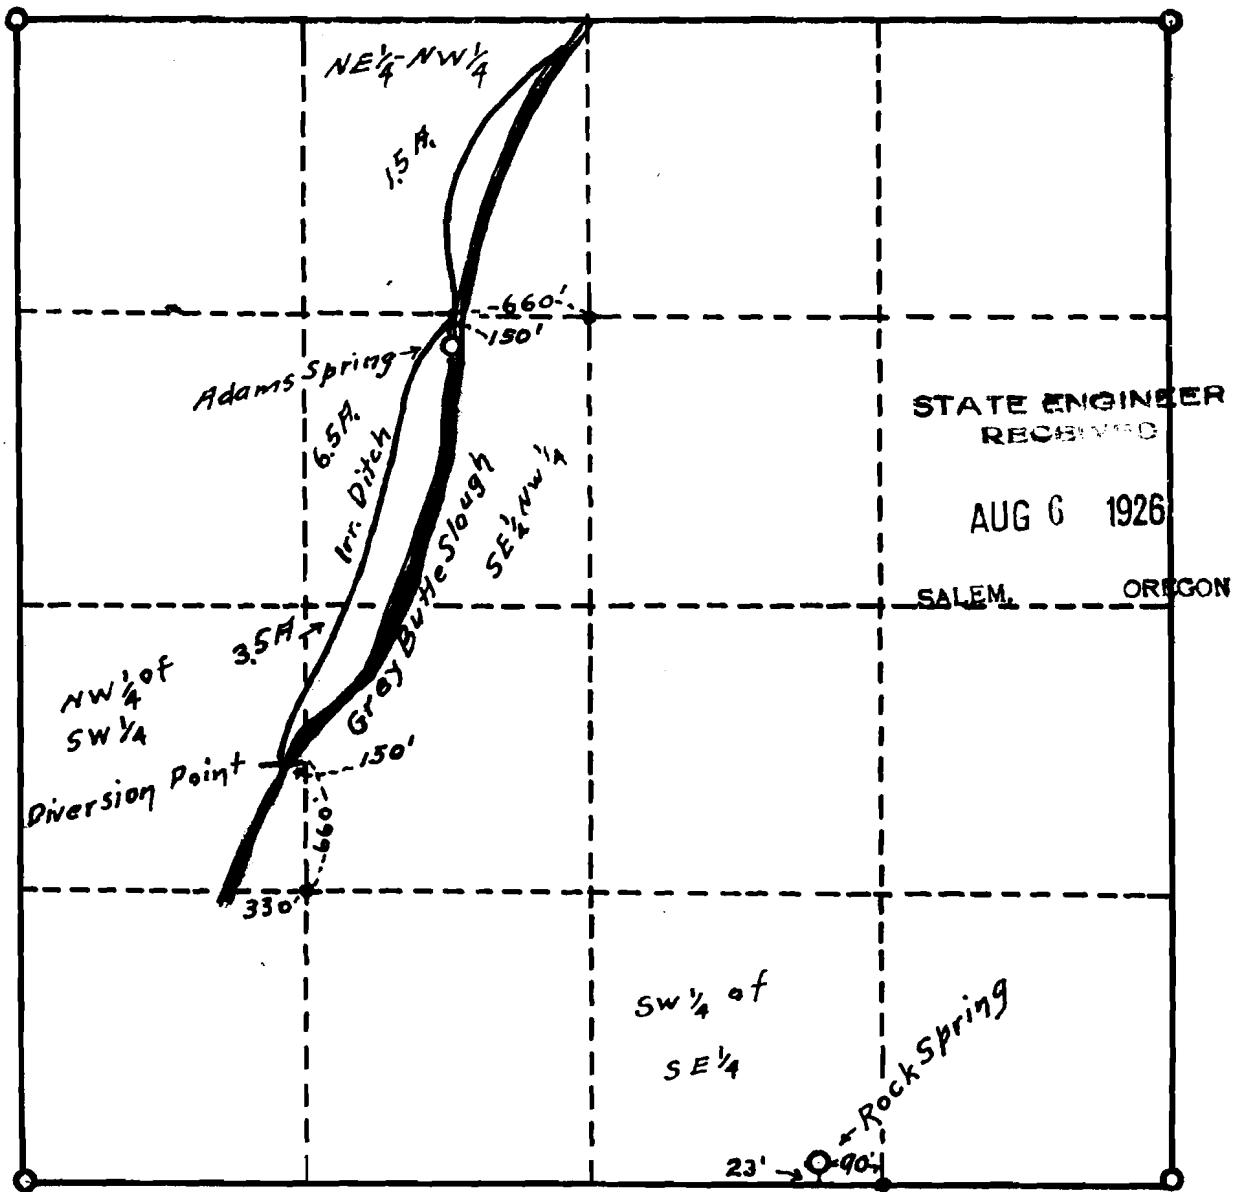

Application No. 10983
Permit No. 7636

7238
7636