


T23S, R7W, WM

SCALE 1" = 1320'

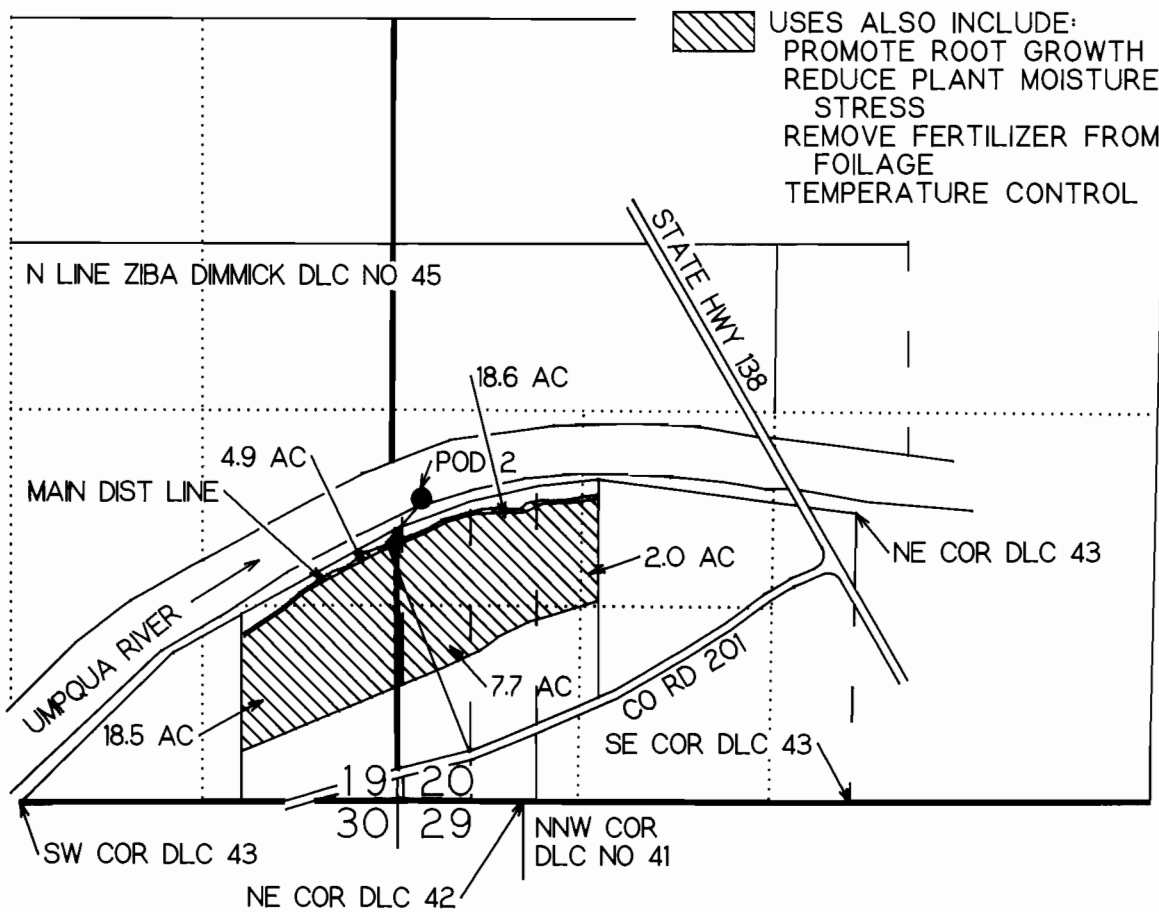

POD IS 2080 FT N AND 700 FT W FROM NE COR JOHN J KELLOGG DLC NO 42

FINAL PROOF SURVEY

UNDER

Application No. 69399 Permit No. 50226


IN NAME OF

INTERNATIONAL PAPER

KELLOGG FOREST TREE NURSERY

Surveyed July 28, 1992 by M E Farr

THIS IS A LOCATION MAP FOR A FINAL PROOF SURVEY BY INTERNATIONAL PAPER. THIS MAP IS FOR THE PURPOSE OF IDENTIFYING THE LOCATION OF THE WATER RIGHT ONLY AND IS NOT INTENDED TO PROVIDE LEGAL DIMENSIONS OR LOCATIONS OF PROPERTY LINES.

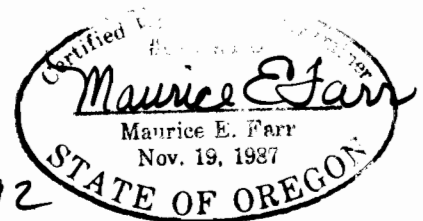


T23S, R7W, WM

SCALE 1" = 1320'



USES ALSO INCLUDE:
PROMOTE ROOT GROWTH
REDUCE PLANT MOISTURE
STRESS
REMOVE FERTILIZER FROM
FOILAGE
TEMPERATURE CONTROL

WILLIAM ROBERTSON
DLC NO 42
JOHN L KELLOGG
DLC NO 41

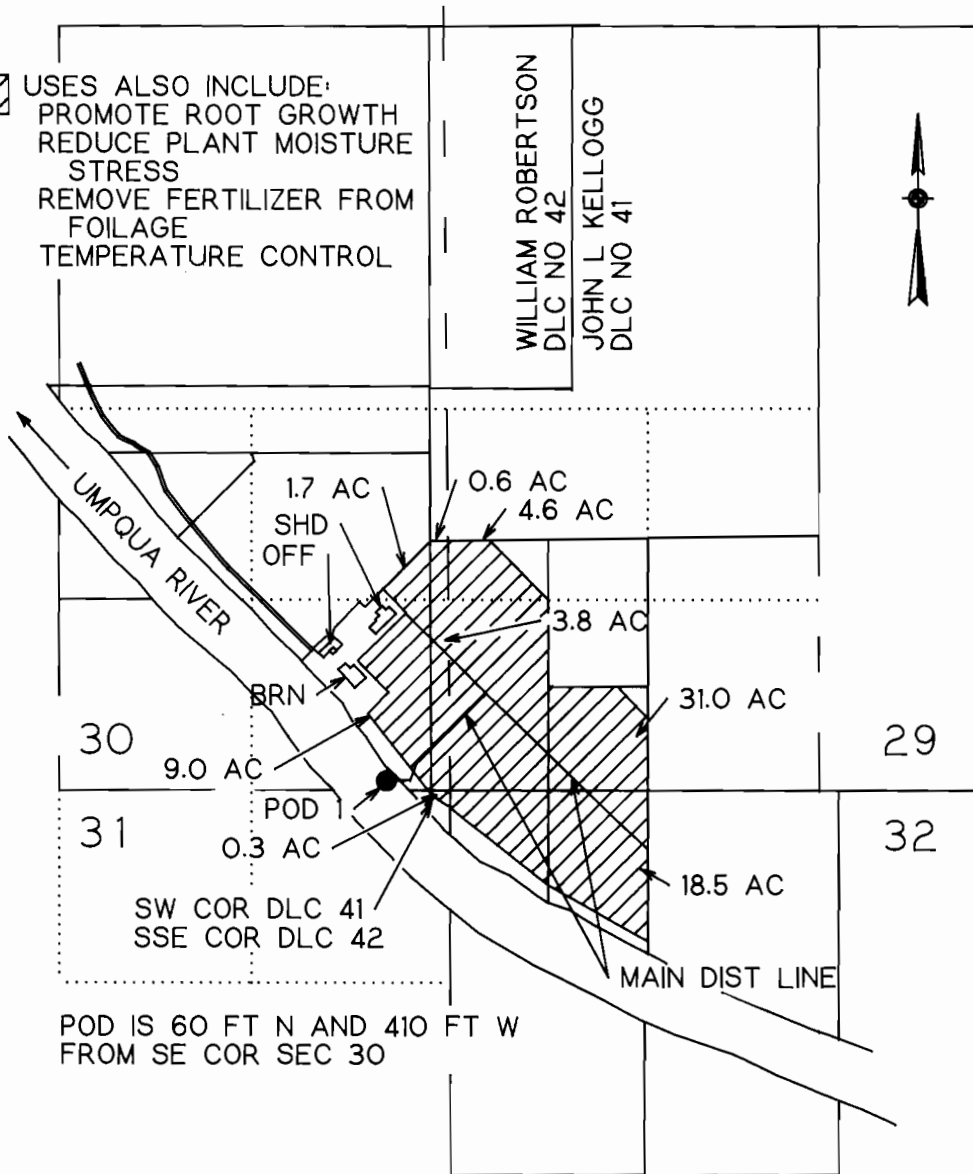

FINAL PROOF SURVEY UNDER

Application No. 69399 Permit No. 50226

IN NAME OF
INTERNATIONAL PAPER
KELLOGG FOREST TREE NURSERY
Surveyed July 28, 1992 by M E Farr

THIS IS A LOCATION MAP FOR A FINAL PROOF SURVEY BY INTERNATIONAL PAPER. THIS MAP IS FOR THE PURPOSE OF IDENTIFYING THE LOCATION OF THE WATER RIGHT ONLY AND IS NOT INTENDED TO PROVIDE LEGAL DIMENSIONS OR LOCATIONS OF PROPERTY LINES.



8-92