


SEC. 34, T29S, R11W WM

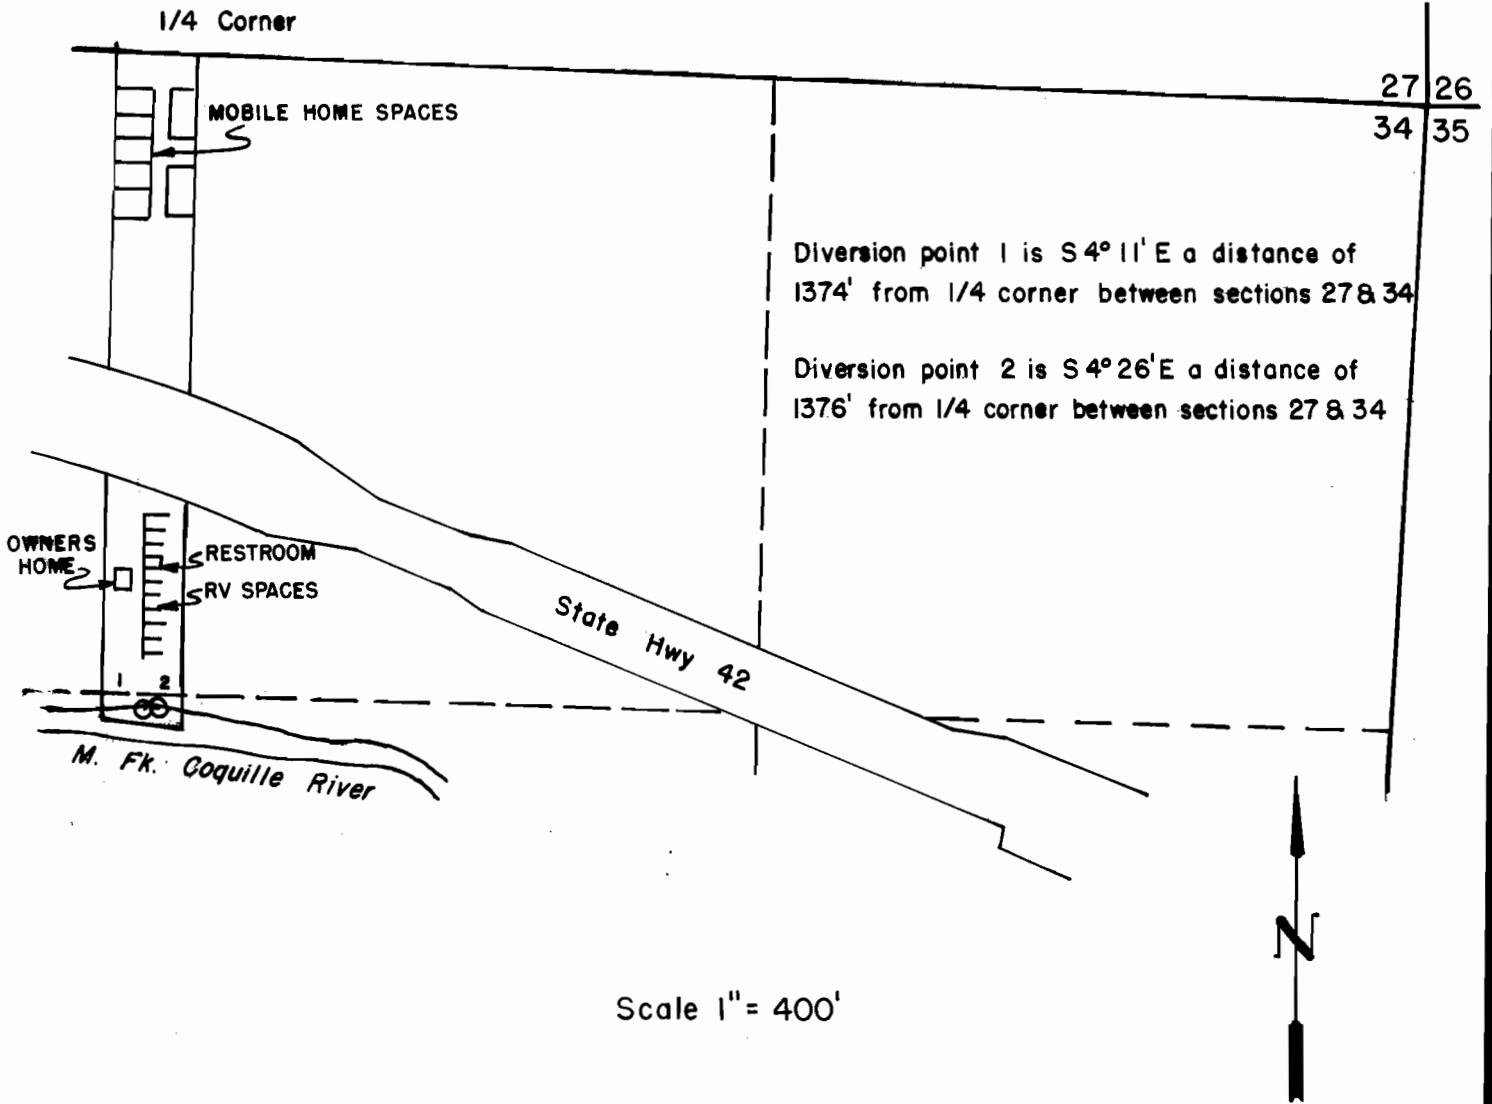

FINAL PROOF SURVEY UNDER



Application No. 69406 Permit No. 50264
IN NAME OF

..SLEEPY.....HOLLOW.....INC.....

Surveyed 9-25 1992 by K. Phelps.....