


T.34 S., R.1 W., W.M

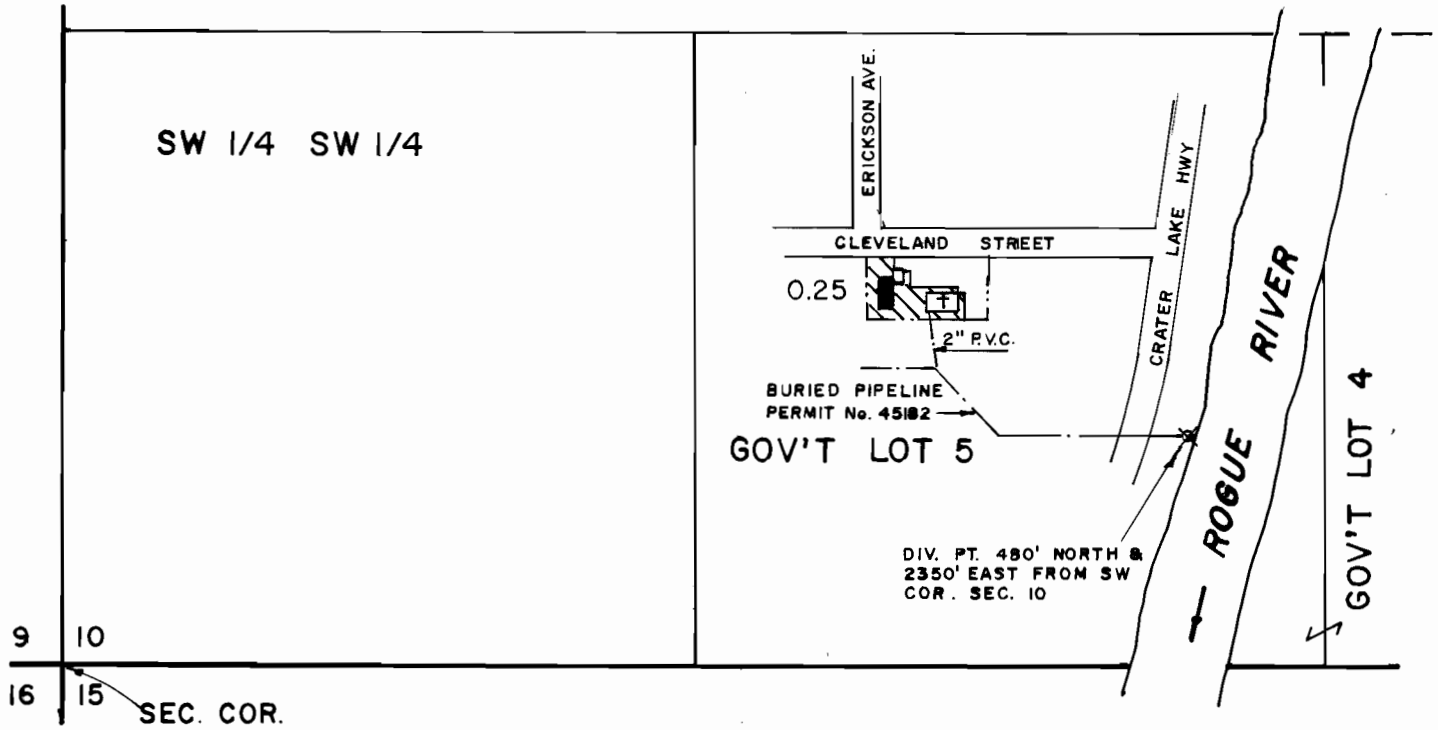

FINAL PROOF MAP

APPLICATION No. 69469 PERMIT No. 50250


IN THE NAME OF

NORMAN R. SMEDES

ST. MARTIN'S EPISCOPAL CHURCH

MAP PREPARED SEPTEMBER 28, 1992 BY GARY D. KAISER

NOTE: THIS MAP HAS BEEN PREPARED
FOR WATER RIGHT PURPOSES ONLY,
NOT FOR PROPERTY BOUNDARY LOCATIONS.

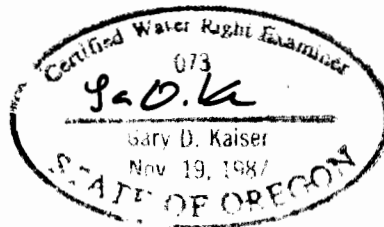

SCALE: 1" = 400'