



TOWNSHIP 26 SOUTH, RANGE 4 WEST, W.M.

RECEIVED

SECTION 14

JUN - 7 1987

WATER RESOURCES DEPT.
SALEM, OREGON

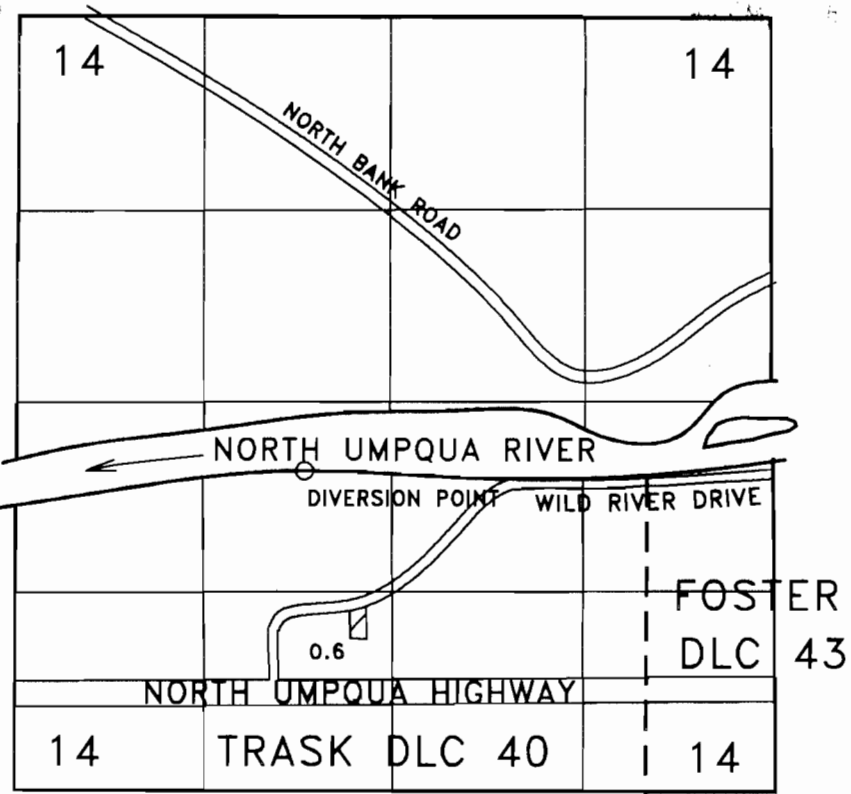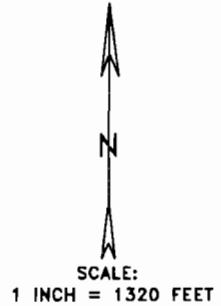

THE DIVERSION POINT IS LOCATED 2170 FEET NORTH AND 3160 FEET WEST FROM THE SOUTHEAST CORNER OF SECTION 14.

FINAL PROOF SURVEY

for

WILLIAM E. WATKINS

APPLICATION 70010

PERMIT 50796

THE PURPOSE OF THIS MAP IS TO IDENTIFY THE LOCATION OF THE WATER RIGHT. IT IS NOT INTENDED TO PROVIDE INFORMATION RELATIVE TO THE LOCATION OF PROPERTY OWNERSHIP BOUNDARY LINES.

