


RESOURCE DEPT.
NO. 100-1001

T.12 S. R.11 W.W.M.
LINCOLN COUNTY, OREGON

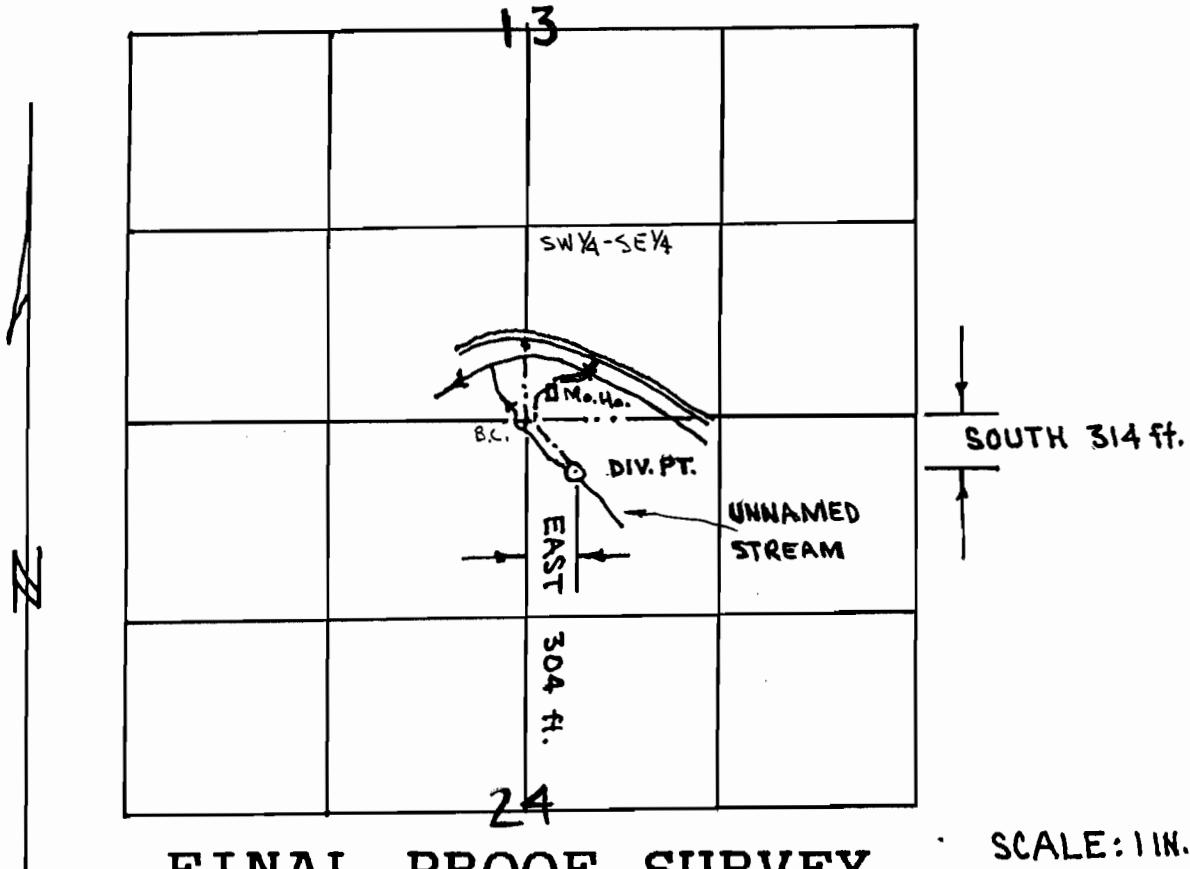

FINAL PROOF SURVEY
UNDER

SCALE: 1 IN. = 1320 ft.

APPLICATION # 70626


PERMIT # 51438

IN THE NAME OF

JOHN R & JANET E. NEWMAN

SURVEYED: September 16, 1992

BY: J. M. Denison

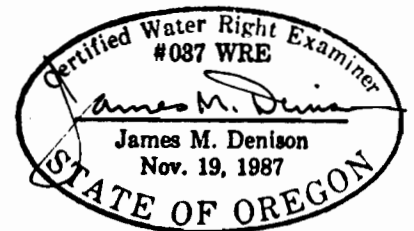

This map prepared solely for the purpose of showing location of a water right, and is not intended for use to provide dimensions or location of property ownership lines.