


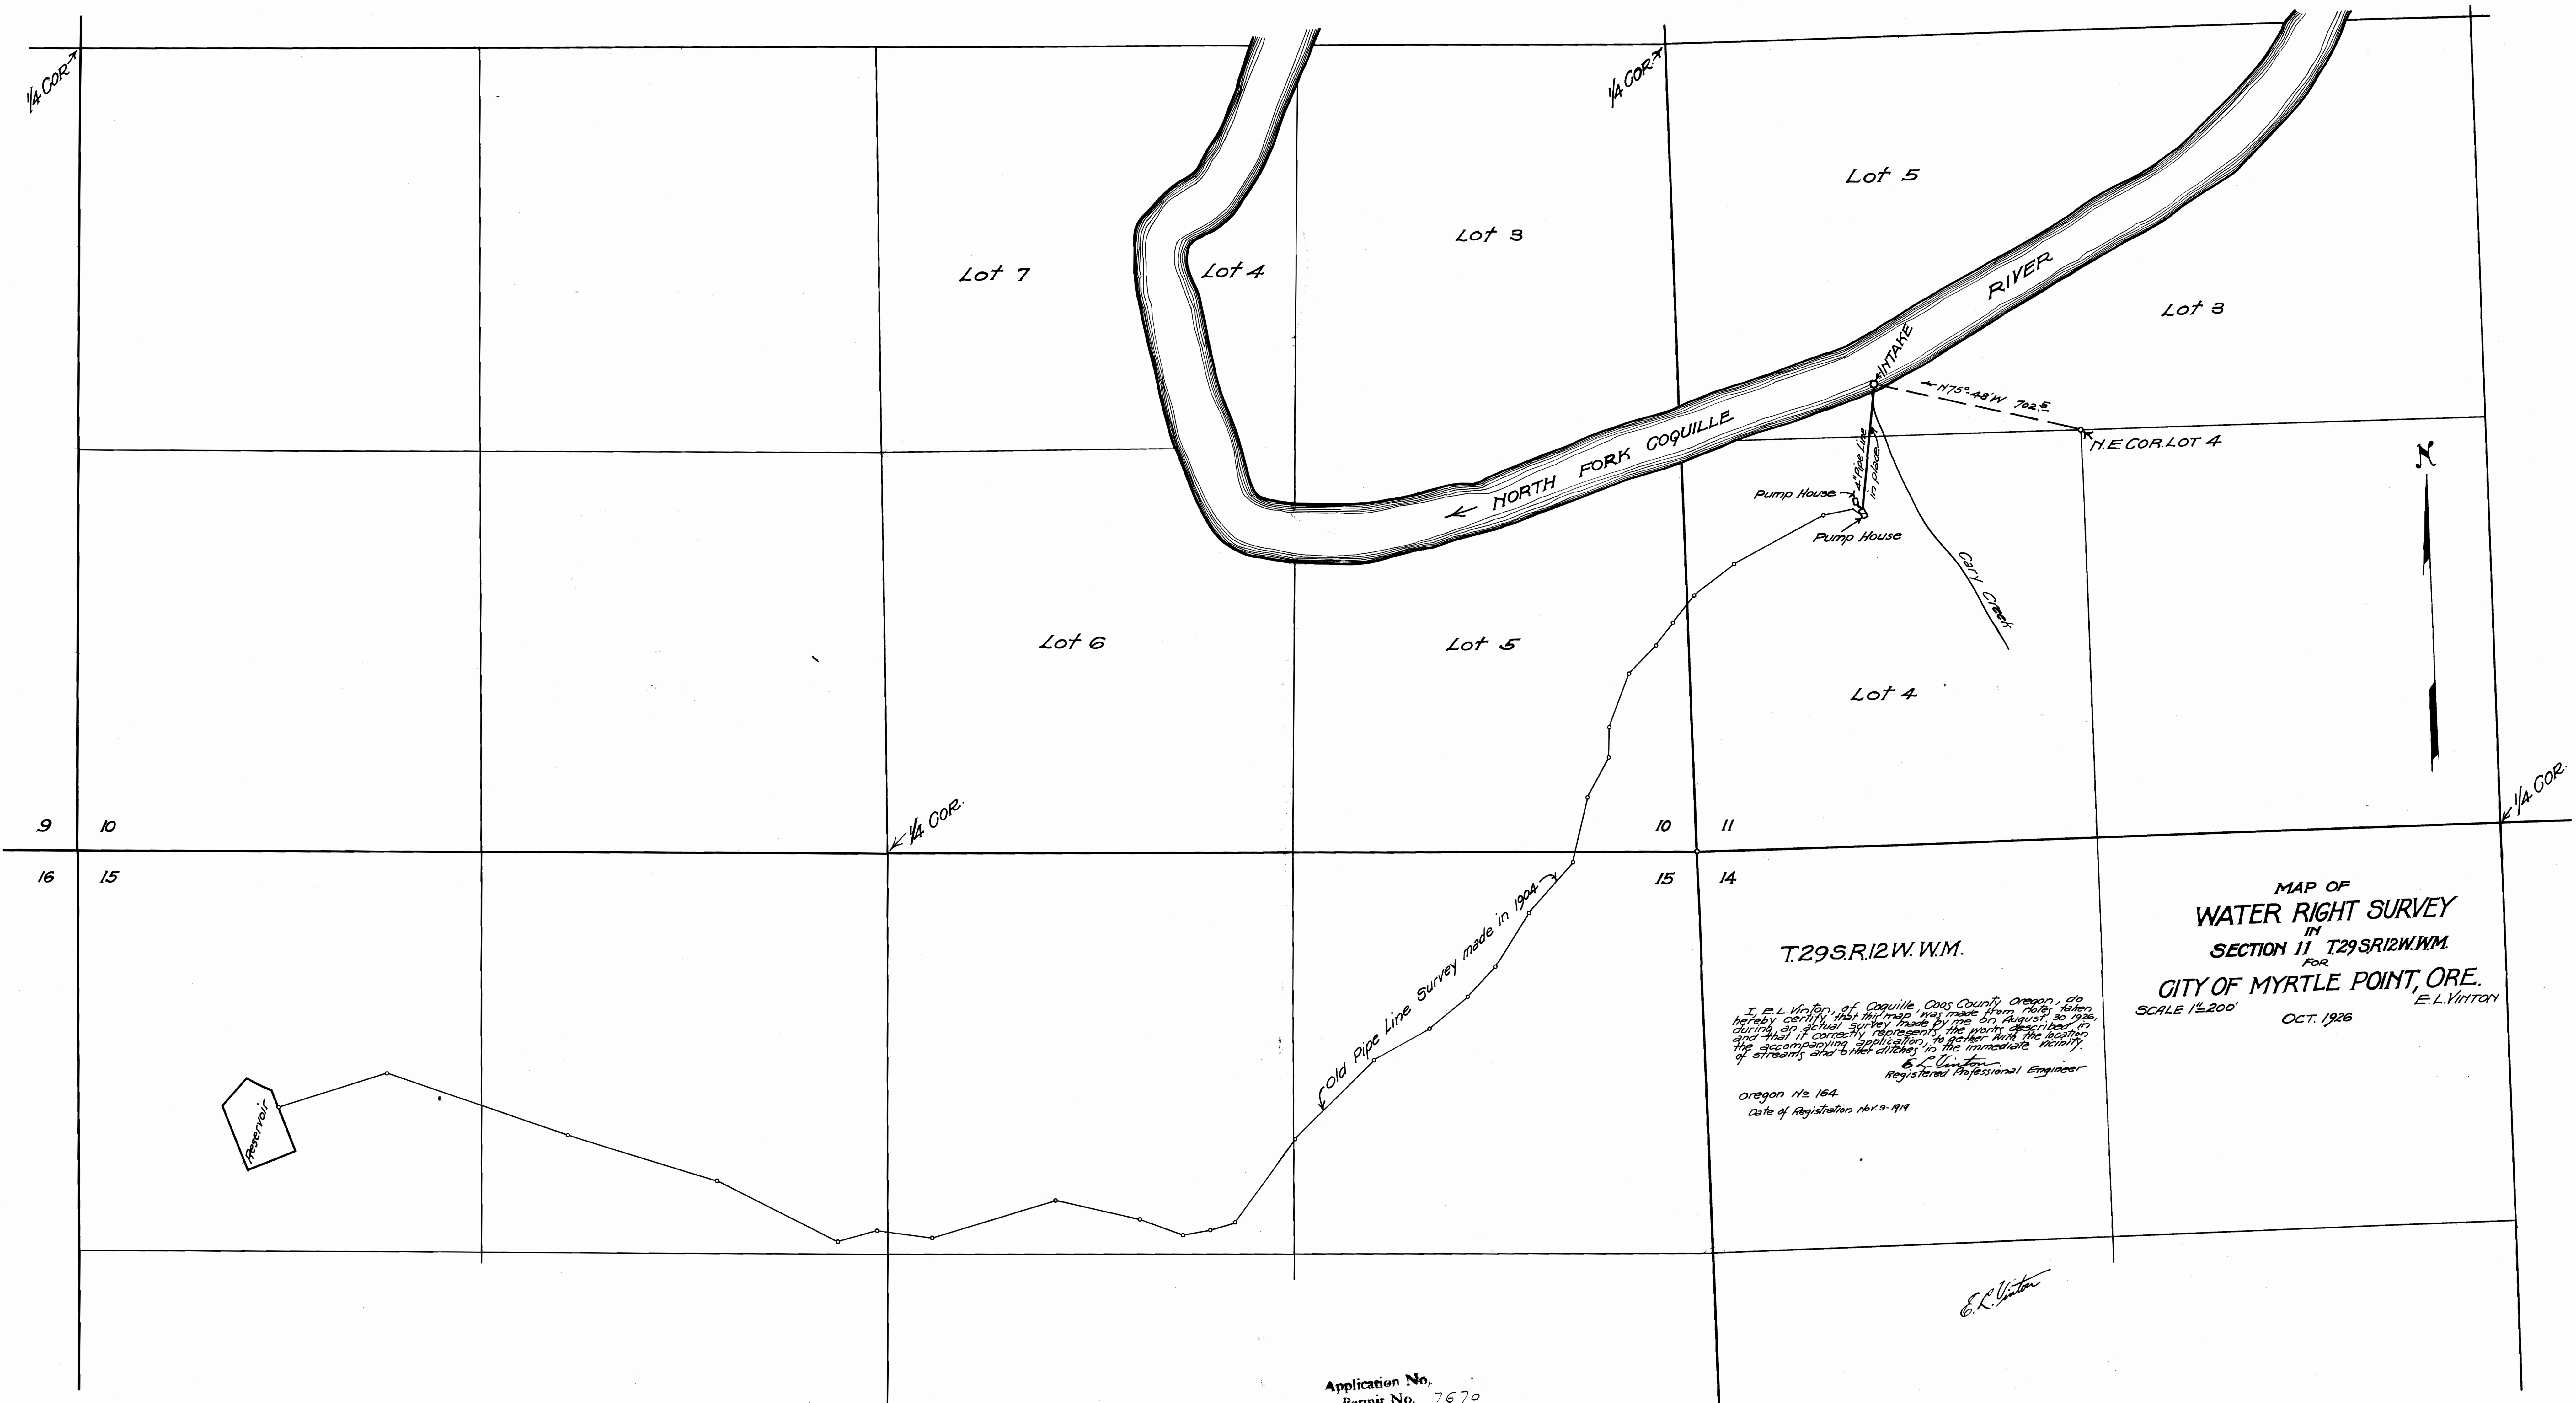

Application No.
Permit No. 7670