


T. 1 & 2 S. R. 1 W. W. M.

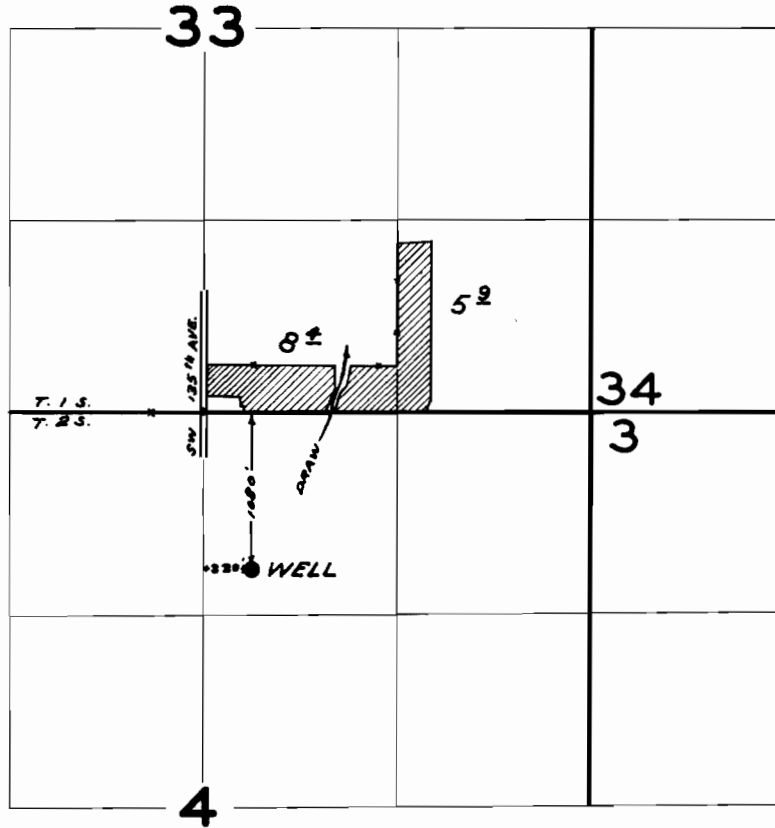

FINAL PROOF SURVEY UNDER

Application No. G-2556 Permit No. G-2367
IN NAME OF

ROBERT SUNAMOTO

Surveyed SEP 13 1967, by V. GARNER