


FINAL PROOF MAP

Application No. G-12078

Permit No. G-11556

T.4S., R.3W. W.M., SECTION 19

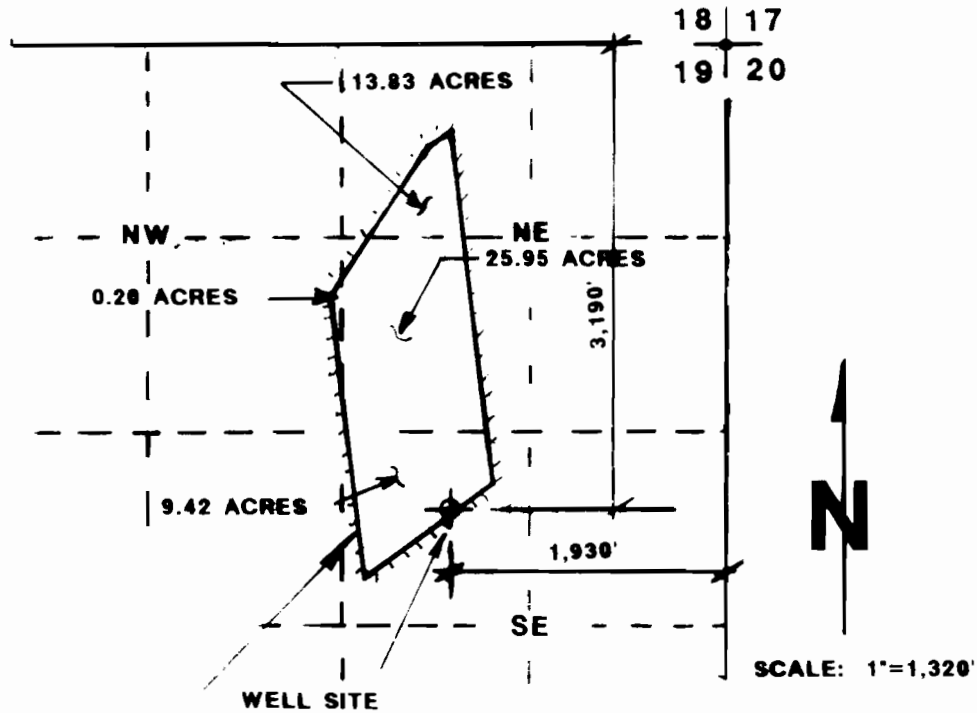

RELATED NURSERY
USE (49.40 ACRES)

NOTE: Map is for the purpose of identifying location of water right and has no intent to dimension or locate property ownership lines.