


T26S, R6W, WM

SCALE 1" = 1320'

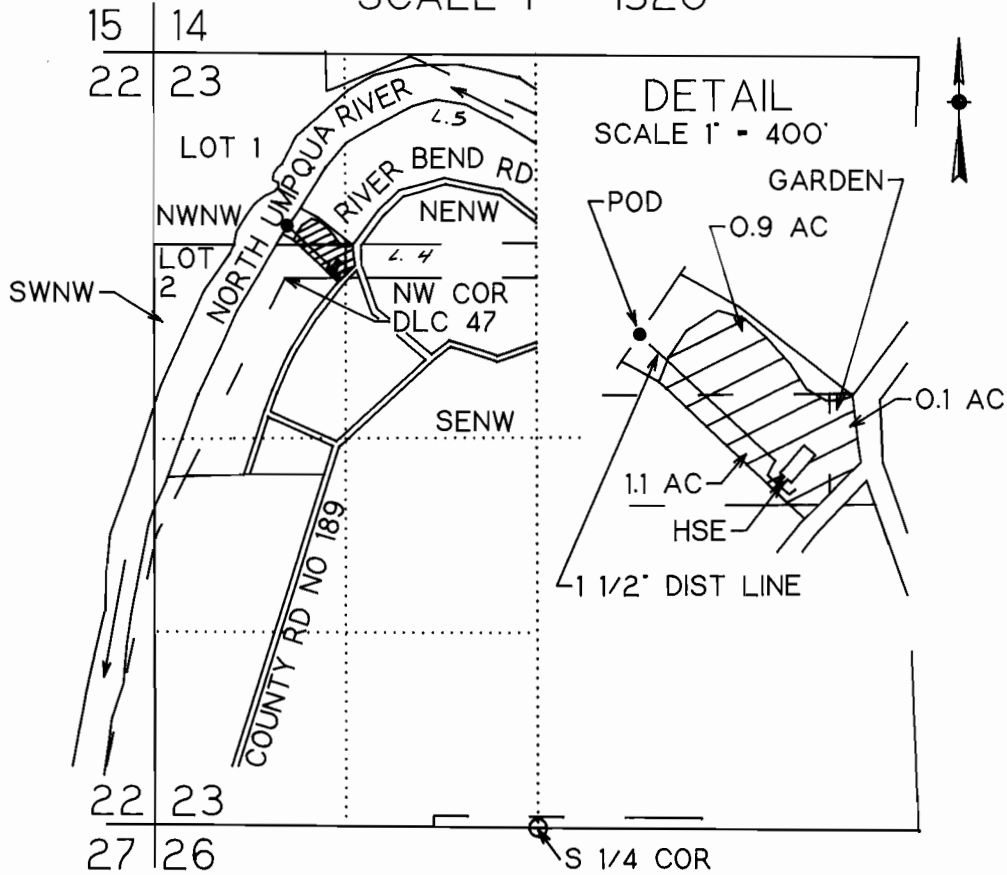

POD IS 1200 FT S AND 900 FT E FROM NW COR SEC 23

FINAL PROOF SURVEY
UNDER

Application No. 69593 Permit No. 50738

IN NAME OF

VIRGINIA C. BEAUDRY

Surveyed October 15, 1992 by M E Farr

THIS IS A LOCATION MAP FOR A FINAL PROOF SURVEY BY VIRGINIA C BEAUDRY. THIS MAP IS FOR THE PURPOSE OF IDENTIFYING THE LOCATION OF THE WATER RIGHT ONLY AND IS NOT INTENDED TO PROVIDE LEGAL DIMENSIONS OR LOCATIONS OF PROPERTY OWNERSHIP LINES.

