


R11103
72408
182

T 40 S., R 4 E., W M

Application No. 69860

Permit No. 50660

Gresham M. & Ruth L. Roskamp
15789 Highway 66
Ashland, OR

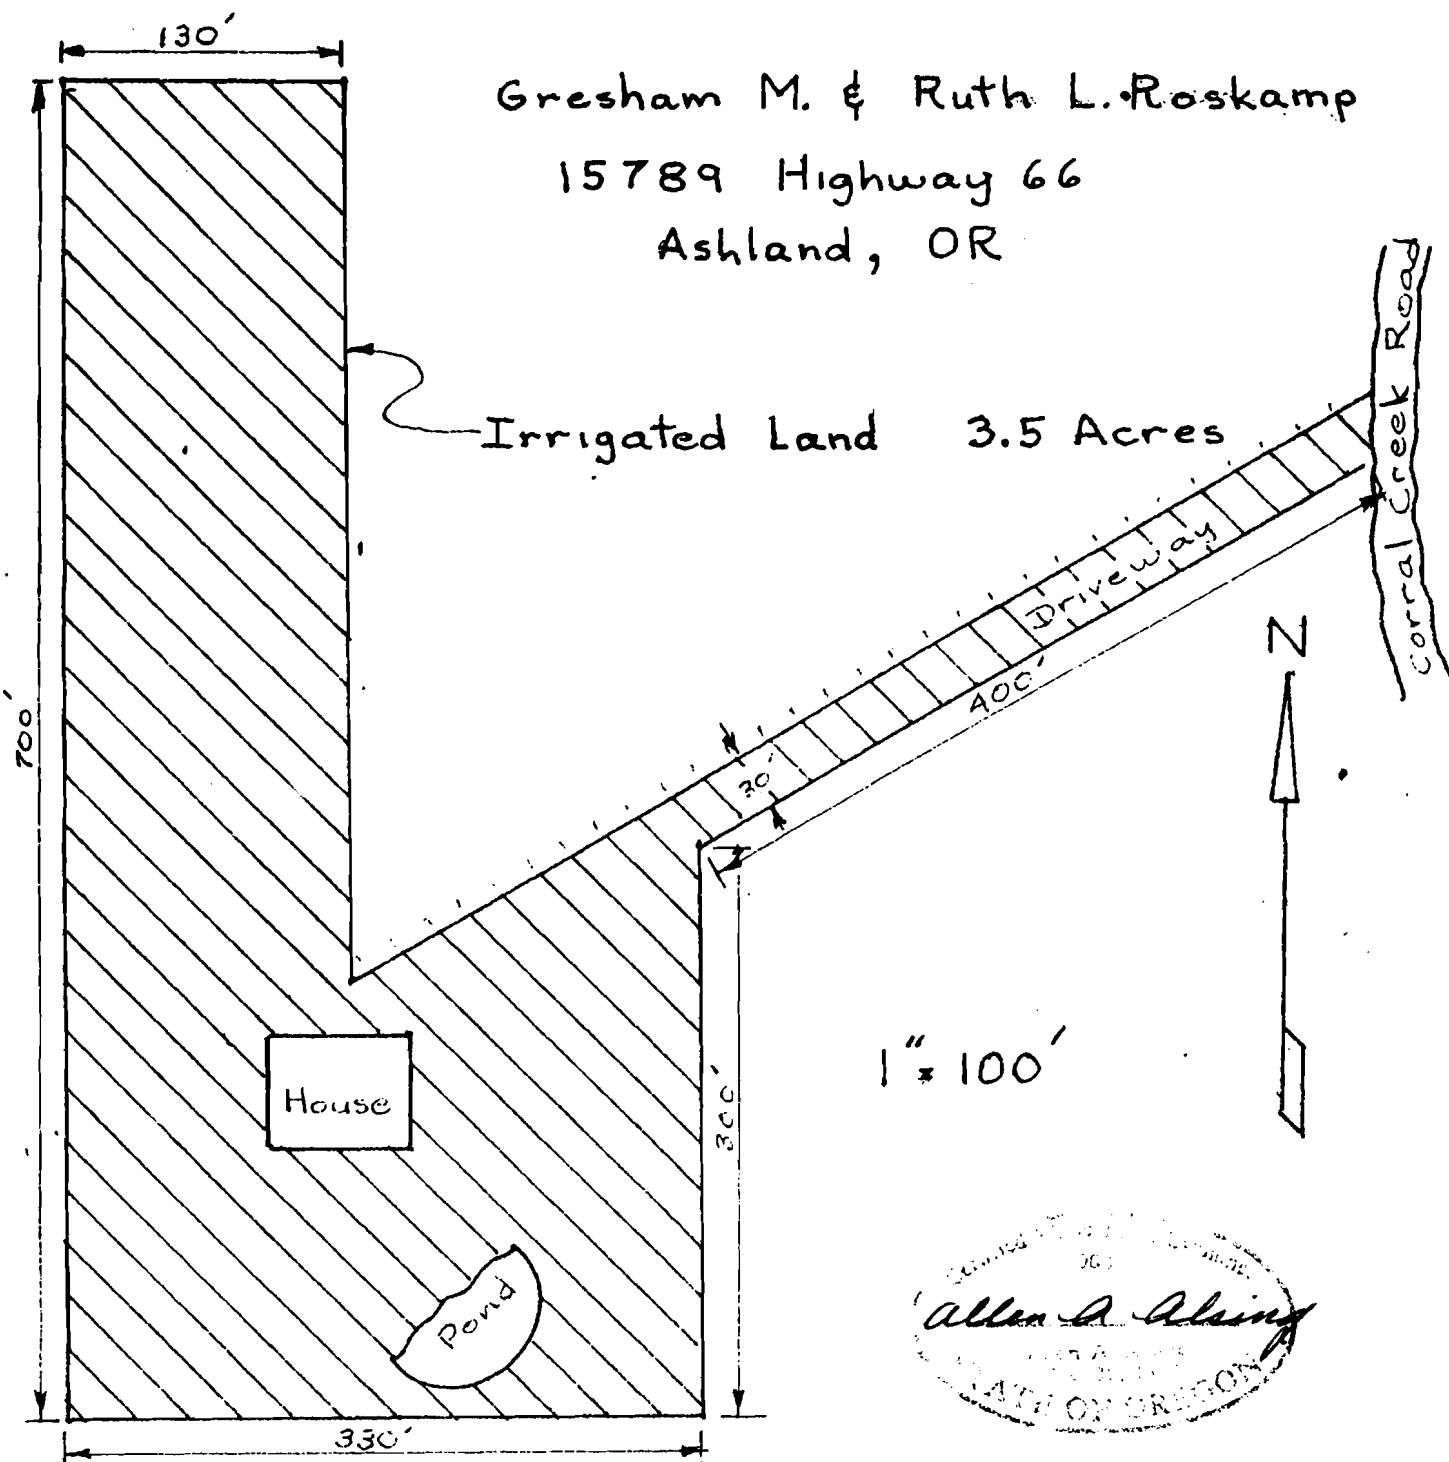


282

T 40 S., R. 4 E., W. M.

APR 24 1992

WATER RIGHT EXAMINED
FEB 1992

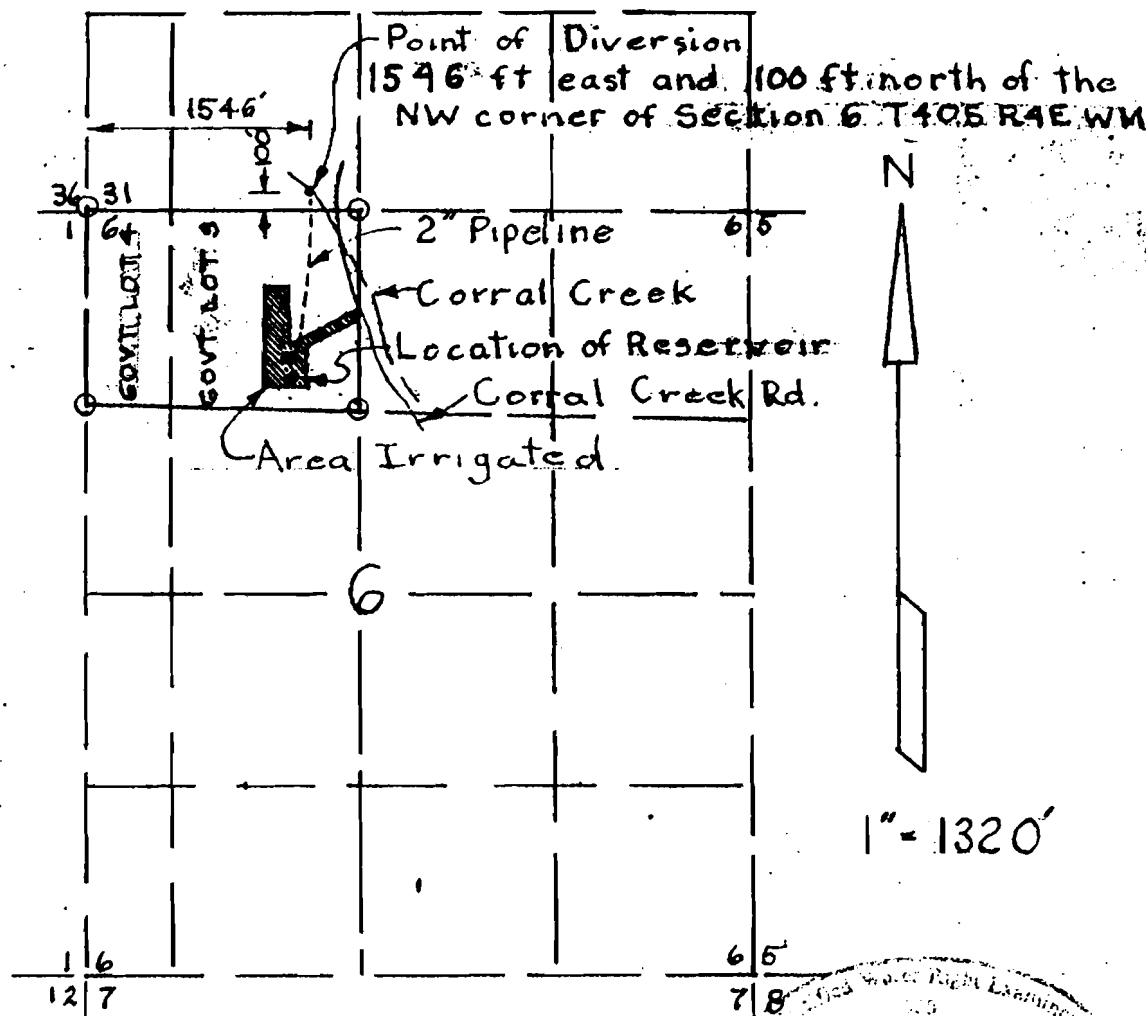

This map was prepared for the purpose of identifying water right locations only and is not intended to show property ownership lines or dimensions.

FINAL PROOF SURVEY
UNDER

Application No R-69860 Permit R-50660
IN THE NAME OF
GRESHAM M. & RUTH L. ROSKAMP

Surveyed August 3, 1992 By Allen A Alsing

Water Right Examined
Allen A Alsing
STATE OF OREGON