


50660
72409

T 40 S., R. 4 E., W. M. RECEIVED 1982

APR 04 1996

WATER RESOURCES DEPT.
SALMON DIVISION

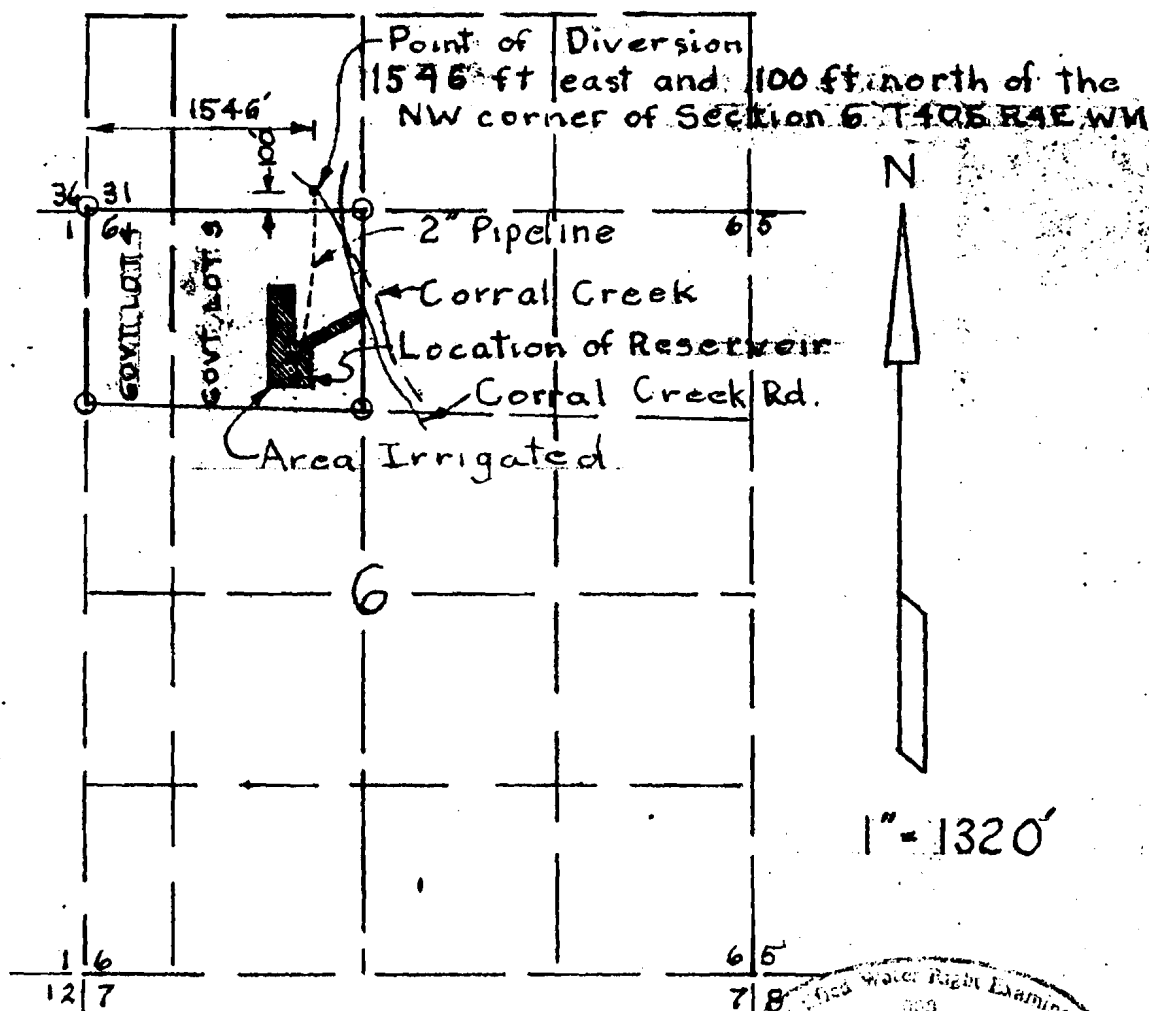


This map was prepared for the purpose of identifying water right locations only and is not intended to show property ownership lines or dimensions.

FINAL PROOF SURVEY
UNDER

Application No R-69860 Permit R-50660
IN THE NAME OF

GRISHAM M. & RUTH L. ROSKAMP

Surveyed August 3, 1992 By Allen A Alsing

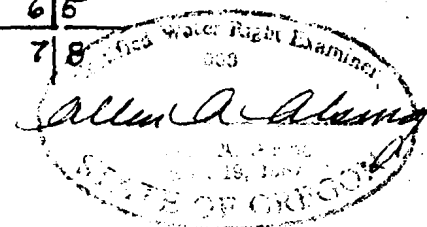

RECEIVED

APR 04 1936

T 40 S., R 4 E., WM

WATER RESOURCES DEPT.
SALEM, OREGON


Application No. 69860

Permit No. 50660

ed 2

Gresham M. & Ruth L. Roskamp
15789 Highway 66
Ashland, OR

Irrigated Land 3.5 Acres

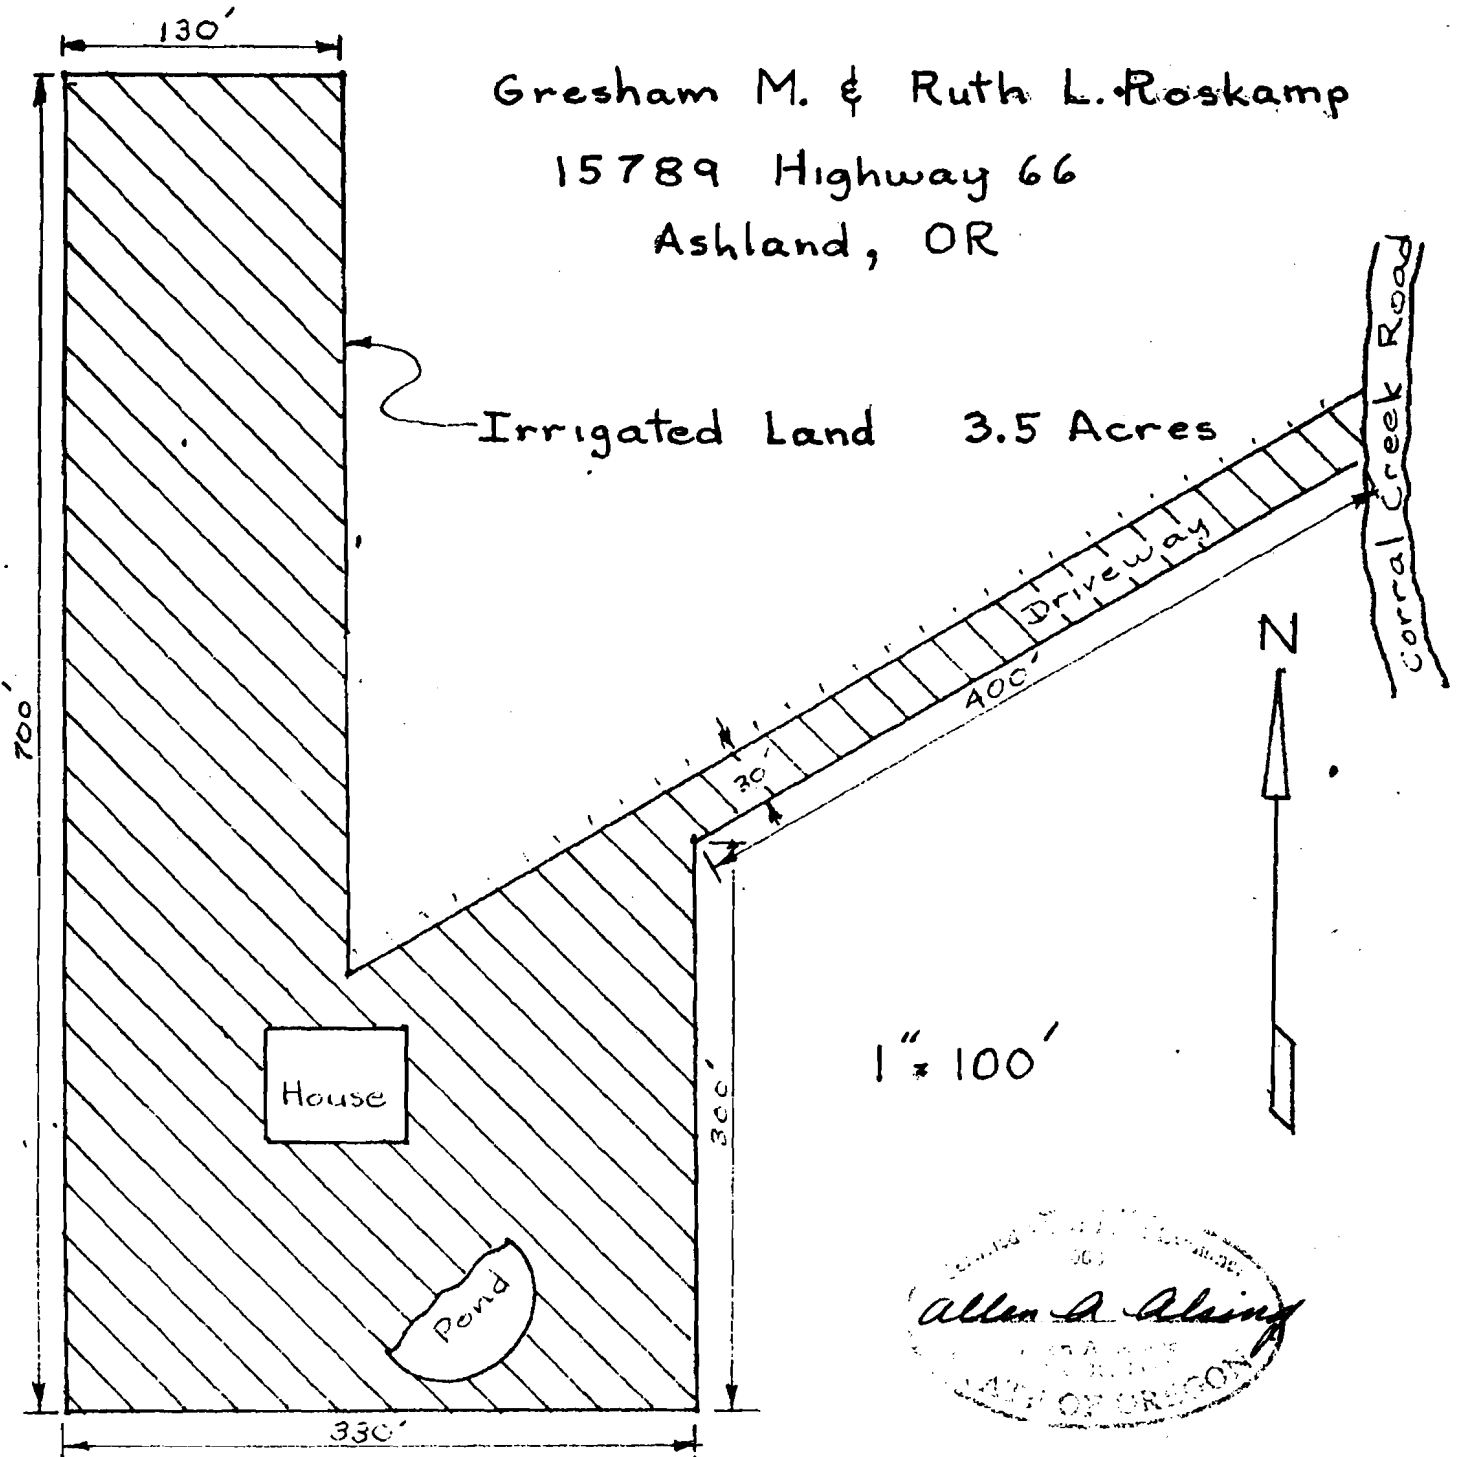

Allen A. Alving
SPECIAL AGENT
STATE OF OREGON