



# T. 6 S., R. 1 E. & 1 W., W.M.

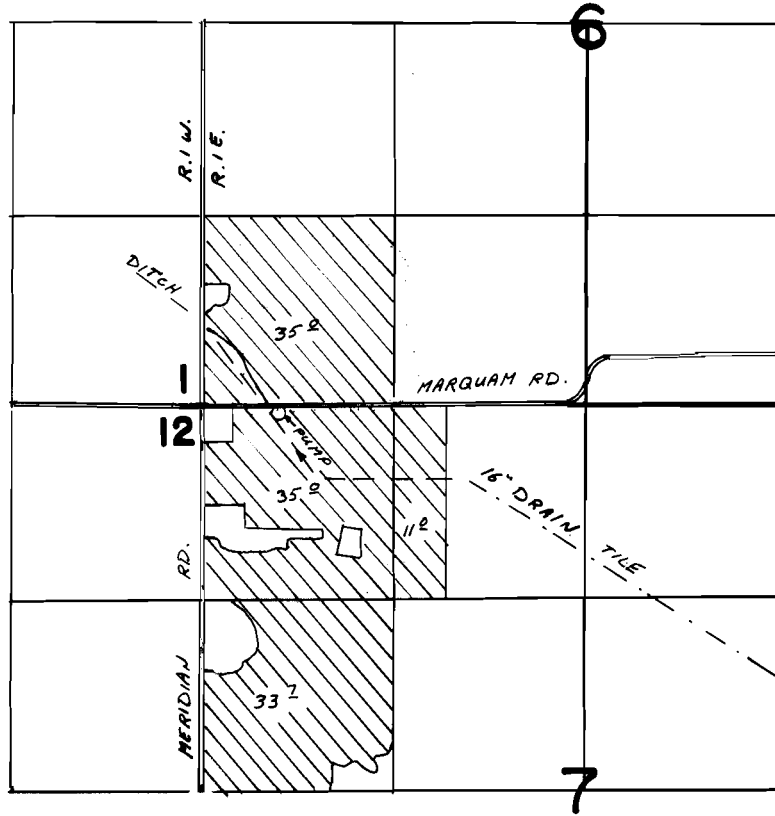

T. 6 S., R. 1 E., W. 1 W.

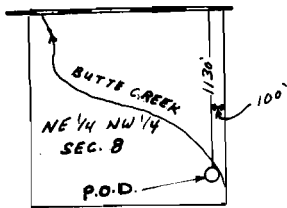

SCALE 1" = 1320'

## FINAL PROOF SURVEY

UNDER


G-10344

G-10144

Application No. 61722 Permit No. 47801  
 IN NAME OF

HAROLD KRAEMER

Surveyed JUN 6 1988, by Z. SALEH

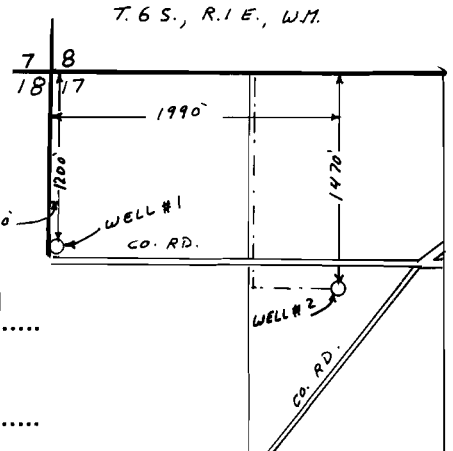

41047-278-109A  
 41005-278-144C  
 5-12-89 Z. f. S.