


T.1S. R.3W. W.M.

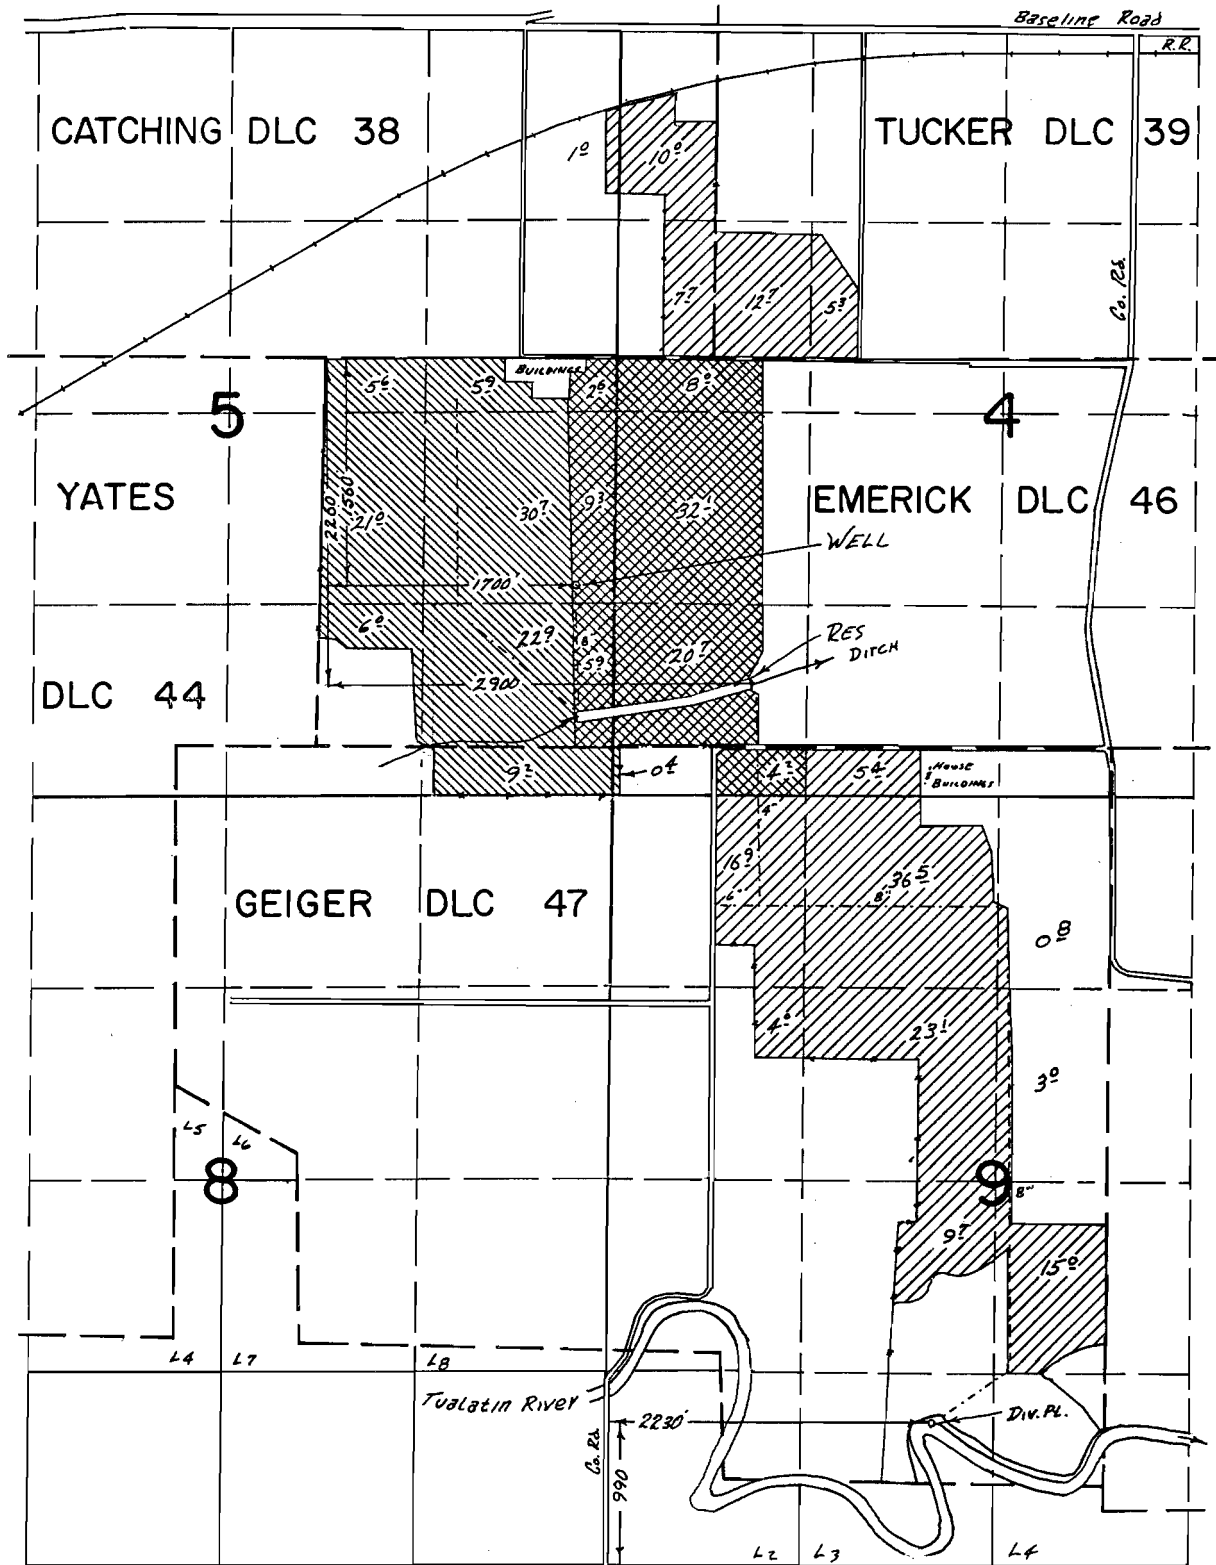

FINAL PROOF SURVEY

UNDER

G-5041
R-44526

G-4751
R-5273

Application No. 44527 Permit No. 33317

LLOYD G. DUYCK

SURVEYED SEP 4 1974 by R. G. MUCKEN



Primary Well
Primary River
Supplemental Well
Supplemental River & Well