


T. 15 S., R. 12 E., W.M.
DESCHUTES COUNTY

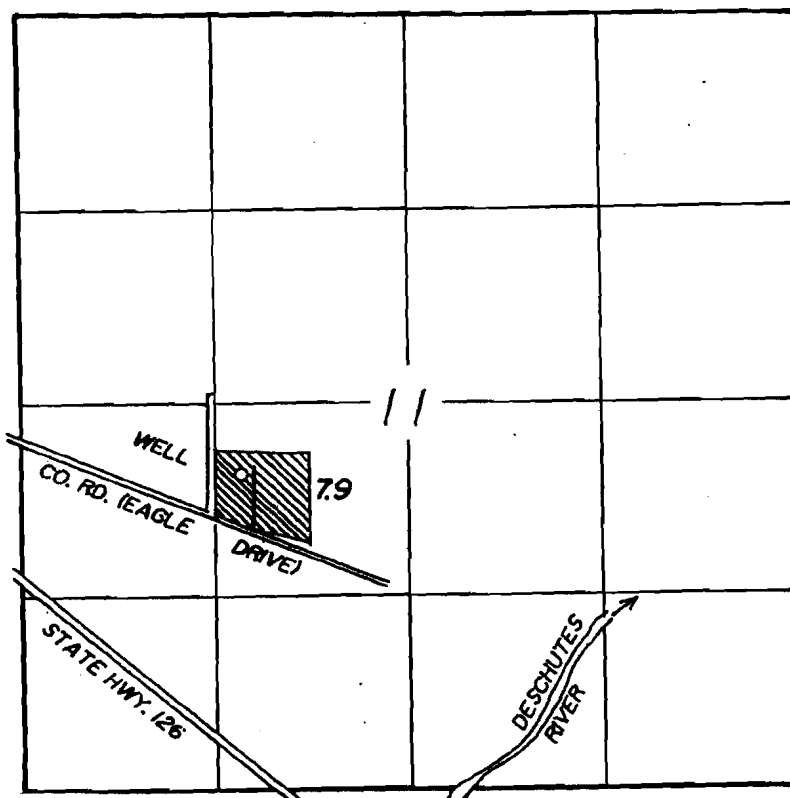

SCALE:
1" = 1320'

WELL LOC: 490' SO. & 215' EAST NW COR. NE1/4 SW1/4

FINAL PROOF SURVEY

UNDER

Application No. 6-11931 Permit No. 6-11261
IN NAME OF

VEVA SKEEN

Surveyed Sept., 1992 by R. POVEY
INSPECTED BY

C. 72417

I, Robert R. Povey, Oregon Certified Water Right Examiner #106, hereby certify the above **FINAL PROOF** map was prepared under my direct supervision.

The preparation of this map is for the purpose of identifying the location of the water right only and has no intent to provide dimensions or locations of property ownership lines.

