


Township 3 & 4 South, Range 3 West, W.M.

Portions of Sections 31 & 32 in Township 3 South
and Sections 5 & 6 in Township 4 South

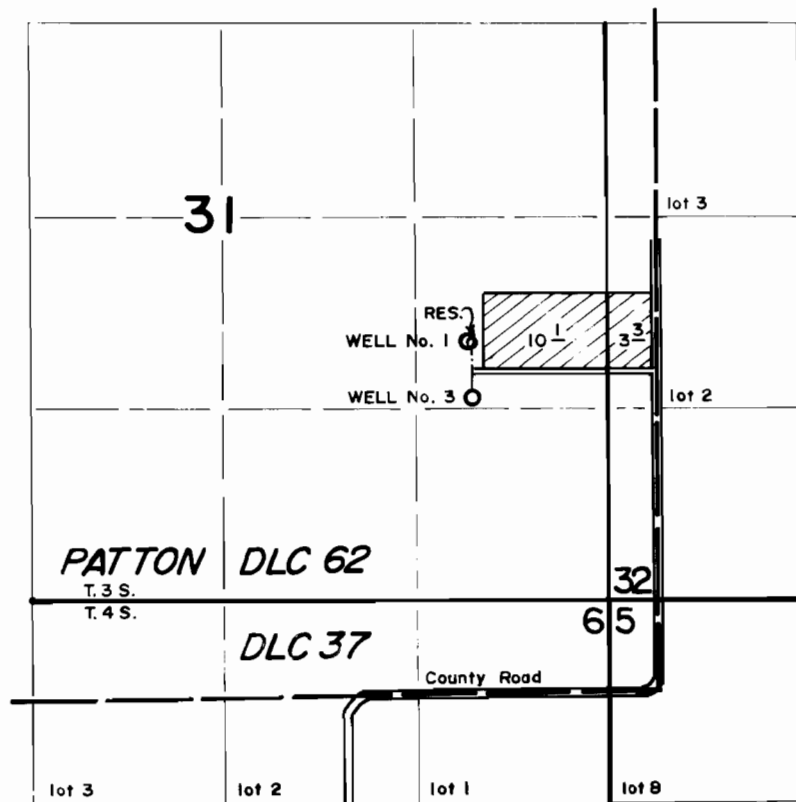

1" = 1320'

WELLS LOCATED: No. 1, 2420' N. and 1290' W.; No. 3, 2030' N. and 1260' W.;
both from SE cor. DLC 37.

FINAL PROOF SURVEY


under

Appl. No. G-12251, Per. No. G-11371

in name of

MARK BENOIT

August 3, November 24, 1992

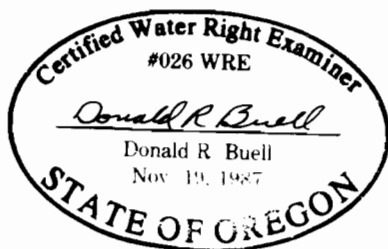

THIS MAP WAS PREPARED FOR THE PURPOSE OF
IDENTIFYING THE LOCATION OF A WATER RIGHT
ONLY AND IS NOT INTENDED TO PROVIDE LEGAL
DIMENSIONS OR LOCATION OF PROPERTY
OWNERSHIP LINES.